

FEB 18 1999

SECTION

Clinton County Remonumentation
South 1/4 Corner Section 31, Victor Township
LAND CORNER RECORDATION CERTIFICATE
Filing Requirement of Act 74, Mich. P.A. 1970

PLAT 004 PAGE 303

For corners in

Form with fields for Clinton (County), Located In, Corner Code #, and numbered sections 1-5 for survey details.

RECORDED

DEC 28 3 47 PM '98

REGISTER OF DEEDS
CLINTON COUNTY, MICH.

Handwritten signature: Ronald Winkley

Register of Deeds Stamp & File Number

I, Samuel J. Clark, in a field survey on July 23, 1998 do hereby state that under requirements of P.A. 74, Michigan P.A. of 1970, the corner points mentioned in lines 1 and 2 above were in conformance with regulations and rules therefore as required in the current manual of survey instructions of the United States Department of the Interior, Bureau of Land Management or by a decree of a Court of Law and/or that the corner points mentioned in lines 3, 4 and 5 above were in conformance with the rules of the Michigan Board of Land Surveyors or by a Decree of a Court of Law; established, re-established, monumented, recovered, found as expressed below:

NOTE: Not more than 2 corners, all in the same town and range, may be recorded on this certificate.

Grid table with columns A-M and rows 1-13, used for recording corner locations.

A. Description of original monument and accessories and/or subsequent restoration:

B-13 South 1/4 Corner Section 31, Bath Twp.
Originally surveyed in 1826 by Lucius Lyon, Deputy Surveyor.
7" Elm North 73° East 8 Links (5.28')
8" Elm North 75 1/2° West 65 Links (42.90')

No history of restoration or of recovery found.
Original corner not found, accessories not verifiable

B. Description of corner evidence found and/or method applied in restoring or reestablishing corner:

B-13 South 1/4 Corner Section 31, Bath Twp.

Found 16" long pointed stone, in excellent condition, standing upright and accompanied by mouth of earthenware jug, bottom of earthenware bottle (made in London), and pieces of bone china imported by W. Pankhurst and Co.

Found large rotted stump (26" Dia.) North 20° East, 5.5' ±

Accepted the stone found as a careful and faithful perpetuation of the position of the original corner due to the apparent age of the earthenware found. It is my opinion that the stone was set by R.H. Colburn at a time when the original corner post or the original accessories may have been present.

C. Description of monument for corner and accessories established to perpetuate locating the position of the corner:

B-13 South 1/4 Corner Section 31, Bath Twp.

\*Set Standard Clinton County Monument surrounded by stones with bottom of earthenware bottle and mouth of earthenware jug.


Set Nail & Tag Southwest Face 36" Elm North 75° West 47.45'
Set Nail & Tag East Face 24" Twin Maple North 10° West 49.90'
Set Nail & Tag West Face 20" Oak North 30° East 46.70'
Set Nail & Tag West Face 18" Maple South 35.85'

\*Standard Clinton County Monument at B-1, Bath Township, S.89°57'08"W. 187.92'

\*Standard Clinton County Monument at C-1, Bath Township, S.89°59'37"E. 2454.04'

\*Standard Clinton County Monument being a 2 1/2" Diameter Steel Tube, 30" long, with a stamped brass cap, restamped #41096, and breakaway magnetic base.

APPROVED BY
CLINTON COUNTY PEER GROUP
DATED 9/23/98
878

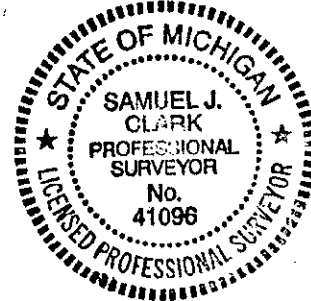

Signed by Samuel J. Clark
Surveyor's Michigan License No. 41096

Date 11/17/98