

REMONUMENTATION
FEB 18 1999

12

Clinton County Remonumentation
SECTION Southeast Corner Section 32 and Southwest Corner Section 33,
T. 6N.-R. 1W., Victor Township
LAND CORNER RECORDATION CERTIFICATE PLAT 004 PAGE 308
Filing Requirement of Act 74, Mich. P.A. 1970

For corners in

<u>Clinton</u>	Located In:	Corner Code #
(County)		
1. Public Land Survey	T. <u>6N</u> R. <u>1W</u> E- <u>13</u>	
	T. _____ R. _____	
	T. _____ R. _____	
	T. _____ R. _____	
2. Property Controlling in Section	S. _____ T. _____ R. _____	
	S. _____ T. _____ R. _____	
3. Miscellaneous Property in Sec.	S. _____ T. _____ R. _____	
	S. _____ T. _____ R. _____	

RECORDED
DEC 28 3 48 PM '98
 REGISTER OF DEEDS
 CLINTON COUNTY, MICH.
Carol Woolley
 Register of Deeds Stamp & File Number

4. Lot No. _____, Recorded Plat _____
 5. Private Claims _____

I, Samuel J. Clark, in a field survey on July 23, 1998 do hereby state that under requirements of P.A. 74, Michigan P.A. of 1970, the corner points mentioned in lines 1 and 2 above were in conformance with regulations and rules therefore as required in the current manual of survey instructions of the United States Department of the Interior, Bureau of Land Management or by a decree of a Court of Law and/or that the corner points mentioned in lines 3, 4 and 5 above were in conformance with the rules of the Michigan Board of Land Surveyors or by a Decree of a Court of Law; established, re-established, monumented, recovered, found as expressed below:

	B	C	D	E	F	G	H	I	J	K	L	M
1												
2	6	5	4	3	2	1						
3												
4	7	8	9	10	11	12						
5												
6	18	17	16	15	14	13						
7												
8	19	20	21	22	23	24						
9												
10	30	29	28	27	26	25						
11												
12	31	32	33	34	35	36						
13												

NOTE: Not more than 2 corners, all in the same town and range, may be recorded on this certificate.

A. Description of original monument and accessories and/or subsequent restoration:

E-13 Southeast corner of Section 32 and Southwest corner of Section 33, Victor Township
 Originally surveyed in 1826 by Lucius Lyon, Deputy Surveyor. Corner not set (falls in lake).
 12" Elm N.89-1/2°W. 6.93 chains with no other witnesses reported

B. Description of corner evidence found and/or method applied in restoring or reestablishing corner:

E-13 Southeast corner of Section 32 and Southwest corner of Section 33, Victor Township
 No evidence of original accessory was found
 Established corner on-line and equidistant between D-13 and F-13


APPROVED BY
 CLINTON COUNTY PEER GROUP
 DATED 9/23/98
JTC

C. Description of monument for corner and accessories established to perpetuate locating the position of the corner:

E-13 Southeast corner of Section 32 and Southwest corner of Section 33, Victor Township
 *Set Standard Clinton County Monument at witness corner lying N.89°-45'-06"E., 385.00' from the actual corner.
 Accessories to said witness being:

- N&T #41096 8" Walnut East, 19.21'
- N&T #41096 18" Oak N42°E, 62.60'
- N&T #41096 20" Oak N08°W, 69.8"
- N&T #41096 8" Maple N48°W, 42.15'

- *Standard Clinton County Monument at F-13, Bath Twp. N.89°-45'-06"E. 2640.66'
- E-1, Bath Twp. (calc'd position) S.89°-45'-06"W. 143.88'
- *Standard Clinton County Monument being a 2 1/2" Diameter Steel Tube, 30" long, with a stamped brass cap, restamped #41096 E-13 REF, and breakaway magnetic base.

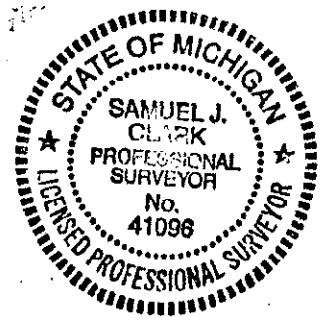

Signed by Samuel J. Clark
 Surveyor's Michigan License No. 41096

Date 12/23/98