

1-2

**Clinton County Remonumentation**  
**South 1/4 Corner Section 33, T. 6N.-R. 1W., Victor Township**  
**LAND CORNER RECORDATION CERTIFICATE**  
**Filing Requirement of Act 74, Mich. P.A. 1970**

LIBER 004 PAGE 309

For corners in

Clinton  
 (County)

Located In: Corner Code #

1. Public Land Survey	T	<u>6N</u>	R	<u>1W</u>	F	<u>13</u>
	T	_____	R	_____	_____	_____
	T	_____	R	_____	_____	_____
	T	_____	R	_____	_____	_____
2. Property Controlling in Section	S	_____	T	_____	R	_____
	S	_____	T	_____	R	_____
3. Miscellaneous Property in Sec.	S	_____	T	_____	R	_____
	S	_____	T	_____	R	_____

RECORDED

DEC 28 3 48 PM '98

REGISTER OF DEEDS  
 CLINTON COUNTY, MICH.

*Carol Woolley*

Register of Deeds Stamp & File Number

4. Lot No. \_\_\_\_\_, Recorded Plat \_\_\_\_\_  
 5. Private Claims \_\_\_\_\_

I, Samuel J. Clark, in a field survey on July 23, 1998, do hereby state that under requirements of P.A. 74, Michigan P.A. of 1970, the corner points mentioned in lines 1 and 2 above were in conformance with regulations and rules therefore as required in the current manual of survey instructions of the United States Department of the Interior, Bureau of Land Management or by a decree of a Court of Law and /or that the corner points mentioned in lines 3, 4 and 5 above were in conformance with the rules of the Michigan Board of Land Surveyors or by a Decree of a Court of Law; established, re-established, monumented, recovered, found as expressed below:

**NOTE: Not more than 2 corners, all in the same town and range, may be recorded on this certificate.**

	B	C	D	E	F	G	H	I	J	K	L	M
1												
2	6		5		4		3		2		1	
3												
4	7		0		9		10		11		12	
5												
6	18		17		16		15		14		13	
7												
8	19		20		21		22		23		24	
9												
10	30		29		28		27		26		25	
11												
12	31		32		33		34		35		36	
13												

A. Description of original monument and accessories and/or subsequent restoration:

F-13 South 1/4 Corner Section 33, Victor Twp.

Originally surveyed in 1826 by Lucius Lyon, Deputy Surveyor.  
 with the following witnesses:  
 15" Aspen N.87 1/2°E. 1.17 chs.  
 6" Tamarack N.50°W. 1.82 chs.

Rec'd Survey by L. Bryan, PS #25832, June 13, 1980, Liber 4, Pg. 917  
 Set 1/2" bar with cap on fence line North, 6 feet South of centerline of road  
 Fd. Nail & tag R.L.S. #19003 South side fence post, North 40.63'  
 Fd. 1/2" bar North 1/4 corner Section 4, T5N, R1W, West, 112.00'  
 Set nail & tag Butternut tree, E.S.E., 65.16'

L.C.R.C. L. Bryan, PS #25832, April 26, 1991, Liber 2, Pg. 370 of corners, same witnesses as rec'd survey L. 4, Pg. 917

B. Description of corner evidence found and/or method applied in restoring or reestablishing corner:

F-13 South 1/4 Corner Section 33, Victor Twp.

Found 1/2" Rerod (no cap) bent South, 0.8' below surface of gravel road.  
 Fd. Nail & tag R.L.S. #19003 South side fence post, North 40.63'  
 Fd. nail & tag Butternut tree, E.S.E., 65.16'  
 Accepted as the best available evidence of the position of the original corner.


APPROVED BY  
 CLINTON COUNTY PEER GROUP  
 DATED 11/17/98  
*SJA*

C. Description of monument for corner and accessories established to perpetuate localing the position of the corner:

F-13 South 1/4 Corner Section 33, Victor Twp.  
 \*Set Standard Clinton County Monument

Nail & tag R.L.S. #19003 South side fence post, North 40.63'  
 Nail & tag R.L.S. #25832 20" Butternut tree, S68°E, 65.16'  
 Set Nail & tag W. Face 24" Oak, N82°E, 188.11'  
 \*Standard Clinton County Monument at G-13,  
 Victor Township, N.89°-40'-27"E 2632.03'  
 \*Standard Clinton County Monument at F-1,  
 Bath Township, S.89°-45'-06"W. 120.30'

\*Standard Clinton County Monument being a 2 1/2" Diameter Steel Tube, 30" long, with a stamped brass cap, restamped #41096 and breakaway magnetic base.

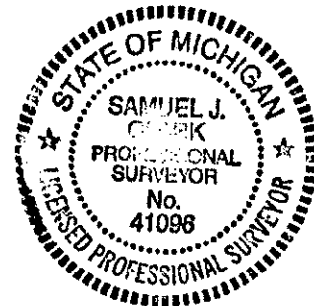

Signed by Samuel J. Clark  
 Surveyor's Michigan License No. 41096

Date 12/23/98