

**SURV
REMONUMENTATION**

SEP 20 1999

**REMONUMENTATION
LAND CORNER RECORDATION CERTIFICATE
Filing Requirement of Act 74, Mich. P.A. 1970**

SEP 20 1999

SECTION
For corners in

| | | |
|---------------------------------------|-------------------------|---------------|
| Clinton (County) | Located in: | Corner Code # |
| | T <u>6N</u> R <u>1W</u> | <u>1-8</u> |
| 1. Public Land Survey | T _____ R _____ | _____ |
| | T _____ R _____ | _____ |
| 2. Property Controlling in Section | S _____ T _____ R _____ | _____ |
| 3. Miscellaneous Property in Sec. | S _____ T _____ R _____ | _____ |
| 4. Lot No. _____ | Recorded Plat _____ | |
| 5. Private Claims _____ | | |

RECORDED

Dec 3 8 14 AM '96

REGISTERED
CLINTON COUNTY
Carroll

LIBER 4, PAGE 185

Register of Deeds Stamp & File Number

| A | B | C | D | E | F | G | H | I | J | K | L | M |
|----|----|----|----|----|----|----|---|---|---|---|---|---|
| 2 | 6 | 5 | 4 | 3 | 2 | 1 | | | | | | |
| 3 | | | | | | | | | | | | |
| 4 | 7 | 8 | 9 | 10 | 11 | 12 | | | | | | |
| 5 | | | | | | | | | | | | |
| 6 | 18 | 17 | 16 | 15 | 14 | 13 | | | | | | |
| 7 | | | | | | | | | | | | |
| 8 | 19 | 20 | 21 | 22 | 23 | 24 | | | | | | |
| 9 | | | | | | | | | | | | |
| 10 | 30 | 29 | 28 | 27 | 26 | 25 | | | | | | |
| 11 | | | | | | | | | | | | |
| 12 | 31 | 32 | 33 | 34 | 35 | 36 | | | | | | |
| 13 | | | | | | | | | | | | |

I, Mark L. VanRaemdonck, in a field survey on, do hereby certify that under requirements of P.A. 74, Michigan P.A. of 1970, the corner points mentioned in lines 1 and 2 above were in conformance with regulations and rules therefore as required in the current manual of survey instructions of the United States Department of the Interior, Bureau of Land Management or by a decree of a Court of Law and/or that the current points mentioned in lines 3, 4 and 5 above were in conformance with the rules of the Michigan Board of Land Surveyors or by a Decree of a Court of Law; established, re-established, monumented, re-monumented, recovered, found as expressed below:

NOTE: Not more than 4 corners, all in the same town and range, may be recorded on this certificate.

A. Description of original monument and accessories and/or subsequent restoration:

- 1.) Original:
Monument: Wood post
Accessories: Y. Oak 20 S½E 241'
B. Oak 24 N1E 346'
- 2.) Charles Hollister, County Surveyor field Book p. 101, 3/11, 12 & 18/1880
Monument: Stone
Accessories: do S54E 13
Burr Oak 6 N66½E 188
Elm 8 S13E 254½
- 3.) Al Tesseberry & Hat Aldrich, field book p. 61, March 11
Monument: gr. post/stone
Accessories: Burr Oak 6 N66½E 188
Elm 8 S13E 254½
- 4.) Kay Don Fluke, survey recorded L. 3, p. 272, 11/2/88
Monument: ½" pipe
Accessories: North 38.36' Oak 24"

N62E 79.64' Walnut 28"
N69E 124.08' Oak 36"

5.) Larry A. Bryan, survey recorded L. 3, p. 385, 7/6/89 & L. 3, p. 507-508, 1/22/90

- Monument: Found 3/4" pipe 1' South of centerline Alward Rd.
Accessories: Found nail & tag #25832 24" Oak North 38.42'
Found nail & tag #25832 28" Walnut N62E 72.62'
Found nail & tag #11370 16" Walnut S70E 78.65'
Found nail & tag #11370 14" Walnut S25W 64.04'

B. Description of corner evidence found and/or method applied in restoring or reestablishing corner:


We were unable to locate the monument described in No. 4 and 5 above due to recent paving of Alward Road. Crossed references in No. 4 and 5 above to determine corner location. This location fits the witness by Hollister in No. 2 above that being: Burr Oak 6 N66½E 188. Excavation for standard monument revealed no further evidence accepted this position as the original corner location based on the best available evidence.

C. Description of monument for corner and accessories to perpetuate locating the position of the corner:

Installed standard Clinton County Monument in mon box at position described above. The monument was stamped "24622" and is witnessed by the following accessories:
North 38.23' Nail & tag #25832 in 36" Oak
N83°E 78.41' Nail & elec. fence insulator in 36" Walnut
S75°E 50.00' Set rerod & cap #24622 in S. shoulder of Alward Rd.
S75°W 50.00' Set rerod & cap #24622 in S. shoulder of Alward Rd.

Signed by Mark L. VanRaemdonck
Surveyor's Michigan License No. 24622

Date 11/26/96

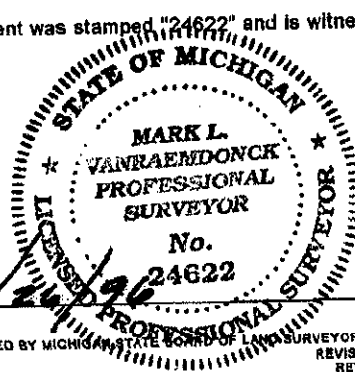

FORM APPROVED BY MICHIGAN STATE BOARD OF LAND SURVEYORS JAN 16, 1971
REVISED MAY 14, 1975
REVISED JAN., 1983

APPROVED BY
CLINTON COUNTY PEER GROUP
DATED 7/17/96
J. 709