

**SURVEY &
REMONUMENTATION**

APR 27 1995

COMMISSION

NE CORNER OF SECTION 1, VICTOR TWP.

**LAND CORNER RECORDATION CERTIFICATE
Filing Requirement of Act 74, Mich. P.A. 1970**

For corners in
Clinton
(County)

Located In: Corner Code #/

LIBER 4, PAGE 47

RECORDED

DEC 12 12 00 PM '94

REGISTER OF DEEDS
CLINTON COUNTY, MICH.
Arden S. Pierson

Register of Deeds Stamp & File Number

1. Public Land Survey T 6N R 1W M-1 *Sy!*
- T _____ R _____
- T _____ R _____
- T _____ R _____
2. Property Controlling S _____ T _____ R _____
- in Section S _____ T _____ R _____
3. Miscellaneous S _____ T _____ R _____
- Property in Sec. S _____ T _____ R _____
4. Lot No. _____, Recorded Plat _____
5. Private Claims _____

	A	B	C	D	E	F	G	H	I	J	K	L
2	6		5		4		3		2			
3												
4	7		8		9		10		11			
5												
6	18		17		16		15		14			
7												
8	19		20		21		22		23			
9												
10	30		29		28		27		26			
11												
12	31		32		33		34		35			
13												

Arden S. Pierson PS, in a field survey on March 11, 19 94, do hereby certify that under requirements of P.A. 74, Michigan P.A. of 1970, the corner points mentioned in lines 1 and 2 above were in conformance with regulations and rules therefore as required in the current manual of survey instructions of the United States Department of the Interior, Bureau of Land Management or by a decree of a Court of Law and/or that the corner points mentioned in lines 3, 4 and 5 above were in conformance with the rules of the Michigan Board of Land Surveyors or by a Decree of a Court of Law; established, re-established, monumented, re-monumented, recovered, found as expressed below:

NOTE: Not more than 4 corners, all in the same town and range, may be recorded on this certificate.

A. Description of original monument and accessories and/or subsequent restoration:
M-1 - Original survey by Harvey Parke DS, 1826.

*(SEE BACK OF SHEET)

APPROVED BY
CLINTON COUNTY PEER GROUP
DATED 11/9/94
Sy!

B. Description of corner evidence found and/or method applied in restoring or reestablishing corner:

Section 1, Victor Township

M-1 - Found 1/2" rod & Rowe Eng. cap R.L.S #11192 - 23.6' East of physical centerline of Meridian Road. Accepted 1/2" rod and cap as a careful and faithful perpetuation of the position of the original corner Replaced 1/2" rod with Standard Clinton County Monument - placed 1/2" rod next to monument. (This corner is to the following Townships - Victor and Ovid)

C. Description of monument for corner and accessories established to perpetuate locating the position of the corner:

M-1 (NE corner Section 1)
Clinton County Monument

- Iron pipe in top center of 10" dia. concrete post -West- 55.69'
- SW corner telephone pedestal -N83°E- 8.25'
- NW corner garage -S64°W- 133.00'
- SE corner foundation house #5008 -S75°W- 126.62'
- Nail & Tag #13039 top of wood fence post -S23°W- 219.75'


*Standard Clinton County Monument is 2 1/2" dia. steel tube 30" long with a stamped brass cap and breakaway magnetic base.

November 1, 1994

Signed by *Arden S. Pierson* 13039

Date _____

Surveyor's Michigan License No. _____

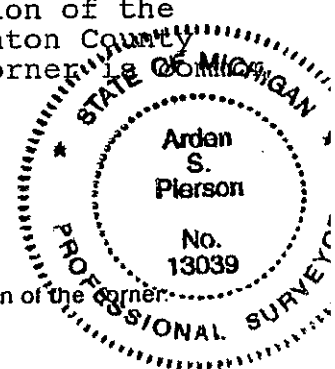

NE CORNER OF SECTION 1, VICTOR TOWNSHIP

Recorded in Liber 2, page 565, by Ronnie M. Lester PS #18998, dated September 30, 1985. "Area in deep road cut. Found bar & cap as called for in in survey as recorded in Liber 2, page 503 of Clinton County survey records." With Witnesses:

Measured West 2625.14' - Measured South 2631.73'
Centerline of telephone box -ENE- 8.24'
Centerline of Meridian Road -West- 23.60'
Centerline of concrete fence post -West- 31.10'
NE corner of garage -SW- 120.78'

LIBER 4, PAGE 48