

SEP 20 1999

SECTION

REMONUMENTATION
LAND CORNER RECORDATION CERTIFICATE
Filing Requirement of Act 74, Mich. P.A. 1970

Victor Township

For corners in

Clinton (County)	Located in:	Corner Code #
1. Public Land Survey	T <u>6N</u> R <u>1W</u>	<u>M-5</u>
	T _____ R _____	_____
	T _____ R _____	_____
	T _____ R _____	_____
2. Property Controlling in Section	S _____ T _____ R _____	_____
	S _____ T _____ R _____	_____
3. Miscellaneous Property in Sec.	S _____ T _____ R _____	_____
	S _____ T _____ R _____	_____
4. Lot No. _____	Recorded Plat _____	
5. Private Claims _____		

RECORDED

DEC 3 8 14 AM '96

REC'D
CLINTON CO. MICH.
Clinton County

LIBER 4, PAGE 188

Register of Deeds Stamp & File Number

I, Mark L. VanRaemdonck, in a field survey on July 22, 1996, do hereby certify that under requirements of P.A. 74, Michigan P.A. of 1970, the corner points mentioned in lines 1 and 2 above were in conformance with regulations and rules therefore as required in the current manual of survey instructions of the United States Department of the Interior, Bureau of Land Management or by a decree of a Court of Law and/or that the current points mentioned in lines 3, 4 and 5 above were in conformance with the rules of the Michigan Board of Land Surveyors or by a Decree of a Court of Law; established, re-established, monumented, re-monumented, recovered, found as expressed below:

NOTE: Not more than 4 corners, all in the same town and range, may be recorded on this certificate.

A	B	C	D	E	F	G	H	I	J	K	L	M
2	6	5	4	3	2	1						
3												
4	7	8	9	10	11	12						
5												
6	18	17	16	15	14	13						
7												
8	19	20	21	22	23	24						
9												
10	30	29	28	27	26	25						
11												
12	31	32	33	34	35	36						
13												

A. Description of original monument and accessories and/or subsequent restoration:

- | | |
|---|---|
| <p>1.) Original: Joseph Wampler 1824
Monument: Wood post
Accessories: W. Oak S4W 52
B. Oak 22 N45 1/2 W 162</p> <p>2.) Hollister Book 3, p. 19
Monument: Stone
Accessories: Hickory 10" S47 1/2 E 50 1/2
do 8 N13 1/2 E 149 1/2</p> <p>3.) Hollister Book 2, p. 73 3/24/1892
Monument: Stone
Accessories: Hickory 12 S44 40' E 50 1/2 L.</p> <p>4.) Hathaway J. Hanes, survey recorded L. 1 p. 473 7/30/74
Monument: None given
Accessories: None given</p> <p>5.) Hathaway J. Hanes, survey recorded L. 1, p. 472 7/30/74
Monument: None given
Accessories: None given</p> | <p>6.) Hathaway J. Hanes, L.C.R.C. recorded L. 1, p. 809 9/3/74
Monument: Found 3/4" pipe under pavement
Accessories: P.K. W. side 24" Maple N15E 111.0'
P.K. P.P. (replaced) S40W 48.26'
Gen. tel. box S80E 39.8'</p> <p>7.) John D. Matonich, Jr., survey recorded L. 4, p. 342, 10/24/85
Monument: Found 3/4" round bar under asphalt pavement
Accessories: N45W 32.07' Set rerod at edge pavement in radius
South 1.6' Physical CL Jason Rd.
East 0.5' Physical CL Meridian Rd.
S35W 47.8' Spike in N. face Power Pole
East 19.17' N'y post of Arrow sign at base</p> <p>8.) Douglas Richardson, L.C.R.C. recorded L. 2, p. 902, 2/3/94
Monument: Found 3/4" round bar in center of Meridian Rd.
Accessories: Rerod and edge of pavement N45W 32.07'
Centerline of Jason Rd. South 1.6'
Centerline of Meridian Rd. East 0.5'
Spike in North side of Power Pole S35W 47.81'
Northerly post of Arrow sign East 19.17'</p> |
|---|---|


B. Description of corner evidence found and/or method applied in restoring or reestablishing corner:

Found 3/4" iron bar as referenced in No. 6, 7 and 8 above. Location fits with monumentation in Highland Hills Plat. Found no conflicting evidence. Excavation to install standard monument revealed no further evidence. Accepted this location as the original corner location based on the best available evidence.

C. Description of monument for corner and accessories to perpetuate locating the position of the corner:

Removed 3/4" iron bar and replaced it with a standard Clinton County Monument and mon box. The monument is standard and is witnessed by the following accessories:

- S60°W 49.63' P.K. in util. pole
- S70°W 42.43' N. edge stop sign post
- S85°E 21.22' S. edge, S. post of double arrow sign
- S75°E 39.45' Top cen. cable box

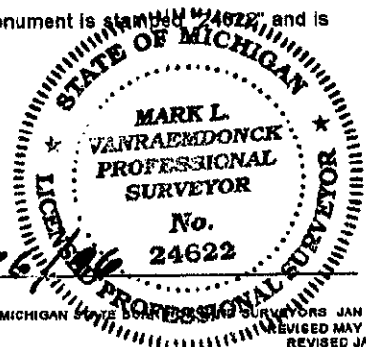

Signed by Mark L. VanRaemdonck
Surveyor's Michigan License No. 24622

Date 11/26/96

FORM APPROVED BY MICHIGAN BOARD OF LAND SURVEYORS JAN 13, 1971
REVISED MAY 14, 1975
REVISED JAN., 1993

APPROVED BY
CLINTON COUNTY PEER GROUP
DATED 7/17/96

J. J. J.