

SURVEY & REMONUMENTATION

MAR 21 1997

REMONUMENTATION COMMISSION SECTIONS 8, 9, 16 & 17, OLIVE TOWNSHIP
LAND CORNER RECORDATION CERTIFICATE
 Filing Requirement of Act 74, Mich. P.A. 1970

For corners in


<u>Clinton</u> (County)	Located in:	Corner Code #
1. Public Land Survey	T <u>6N</u> R <u>2W</u>	<u>E-5</u>
2. Property Controlling in Section	T ___ R ___	___
3. Miscellaneous Property in Sec.	T ___ R ___	___
	S ___ T ___ R ___	___
	S ___ T ___ R ___	___
	S ___ T ___ R ___	___

RECORDED
 Oct 11 8 52 AM '96
 REGISTERED DEEDS
 CLINTON COUNTY, MICH.
Arden S. Pierson
 LIBER 4, PAGE 166
 Register of Deeds Stamp & File Number

4. Lot No. _____, Recorded Plat _____
 5. Private Claims _____

I, Arden S. Pierson P.S., in a field survey on August 13, 19 96 do hereby state that under requirements of P.A. 74, Michigan P.A. of 1970, the corner points mentioned in lines 1 and 2 above were in conformance with regulations and rules therefore as required in the current manual of survey instructions of the United States Department of the Interior, Bureau of Land Management or by a decree of a Court of Law and for that the corner points mentioned in lines 3, 4 and 5 above were in conformance with the rules of the Michigan Board of Land Surveyors or by a Decree of a Court of Law; established, re-established, monumented, recovered, found as expressed below:

NOTE: Not more than 2 corners, all in the same town and range, may be recorded on this certificate.

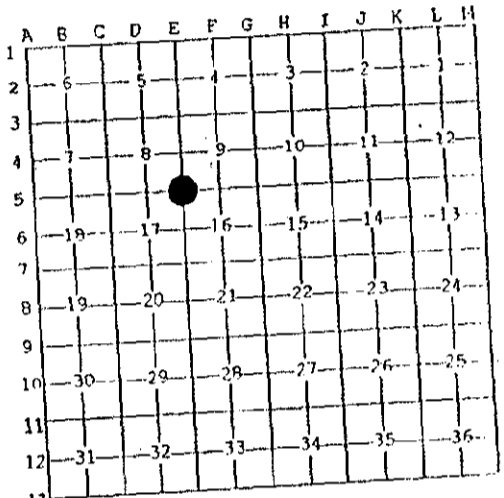

- A. Description of original monument and accessories and/or subsequent restoration:
- ◆ Original survey by Hervey Parke, DS, 1826. Set post corner Sections 8, 9, 16 & 17, witnessed by: Willow 5" - N65°E - 73 links; Elm 12" - N84½°W - 145 links.
 - ◆ Survey by Chas. Hollister, County Surveyor, dated May 13, 1892, Hollister Field Book 2. Found old stake section corner 8, 9, 16 & 17. Set large stone and ironware around it. No witnesses were given.

(OVER)

- B. Description of corner evidence found and/or method applied in restoring or reestablishing corner:
- Found 1" pin (buried 12") S70°E - 11.89' from recorded corner. (Originally found stone over 1" pin.) Dug below pin and at 3' found pointed stone and stake with crockery and metal around stone (set by Chas. Hollister in May, 1892). Accepted pointed stone and stake with crockery and metal around stone as a perpetuation of the position of the original corner.
- *Set Standard Clinton County Monument.



C. Description of monument for corner and accessories established to perpetuate locating the position of the corner of

- Section Corner Common to Sections 8, 9, 16 & 17**
- *Set Standard Clinton County Monument
 - Nail & tag #13039 in NW side 38" Oak - S68°W - 141.50'
 - Nail & tag #13039 in SW side Telephone Pole - S05°E - 120.97'
 - Nail & tag #13039 in Top Utility Pole Stub - S70°W - 63.45'
 - Nail & tag #13039 in SE Side Utility Pole - N38°E - 36.33'
- (Recorded corner is N75°17'48"W - 11.38')

*Standard Clinton County Monument is a 2½" dia. Steel tube 30" long with a stamped brass cap and a breakaway magnetic base.

Signed by Arden S. Pierson
 Surveyor's Michigan License No. 13039

Date August 15, 1996

APPROVED BY
 CLINTON COUNTY FILE GROUP
 DATED 8/21/96
CS

- ◆ LCRC by Clyde K. Stephens, PS, #3829, dated June 7, 1971, Liber 1, pages 31-32. A 3/4" iron pipe found in the centerline of two section line roads (Jason Road and Loomis Road). Witnesses:
 - Stephens Engineering tag in 24" Apple - S80°04'W - 157.20'
 - Stephens tag in power pole - S58°23'W - 55.35'
 - Stephens tag in power pole - S15°00'E - 141.15'

- ◆ LCRC by Arden S. Pierson, PS, #13039, dated April 19, 1977, Liber 2, page 176. Found 1/2" pipe in center of intersection of Jason and Loomis Roads. Witnessed by:
 - N62°W - 55.20' - Telephone Pole (Stephen's tag)
 - N65°E - 47.56' - Power Pole
 - S12°E - 126.19' - New Power Pole

- ◆ Certified Boundary Survey by Austin Williams, dated January 1980, Liber 2, pages 244-245. Witnesses:
 - S62°W - 55.20' - Telephone pole (Stephens tag)
 - N65°E - 47.56' - Power pole
 - S12°E - 126.19 - Power pole

- ◆ Certificate of Survey by Fred White, PS, #12034, dated November 6, 1985, Liber 2, page 930.

- ◆ LCRC by Arden S. Pierson, PS, #13039, dated December 27, 1993, Liber 2, page 947. Found 1/2" pipe, witnessed by:
 - 3/4" Pin - S70°E - 11.81' (buried 12")
 - Telephone pole stub - S62°W - 55.18'
 - Power Pole - N52°E - 41.60'
 - Pole - S12°E - 126.45'