

SURVEY &
REMONUMENTATION

REMONUMENTATION
SECTION 3, OLIVE TOWNSHIP
LAND CORNER RECORDATION CERTIFICATE
Filing Requirement of Act 74, Mich. P.A. 1970

JAN 17 1996

For corners in **COMMISSION**
Clinton
(County)

Located In:

Corner Code #

RECORDED

1. Public Land Survey	T	<u>6N</u>	R	<u>2W</u>	<u>H-3</u>
	T		R		
	T		R		
	T		R		
2. Property Controlling in Section	S		T		
	S		T		
3. Miscellaneous Property in Section	S		T		
	S		T		

SEP 27 8 14 AM '95

REGISTERED FOR
CLINTON COUNTY RECORDS

Arden S. Pierson

LIBER 4, PAGE 70
Register of Deeds Stamp & File Number

4. Lot No. _____, Recorded Plat _____
5. Private Claims _____

Arden S. Pierson P.S. in a field survey on August 1, 1995, do hereby certify that under requirements of P.A. 74, Michigan P.A. of 1970, the corner points mentioned in lines 1 and 2 above were in conformance with regulations and rules therefore as required in the current manual of survey instructions of the United States Department of the Interior, Bureau of Land Management or by a decree of a Court of Law and/or that the corner points mentioned in lines 3, 4 and 5 above were in conformance with the rules of the Michigan Board of Professional Surveyors or by a Decree of a Court of Law; established, re-established, monumented, re-monumented, recovered, found as expressed below:

	A	B	C	D	E	F	G	H	I	J	K	L	M
2	6		5		4			3		2			
3								●					
4	7		8		9			10		11		12	
5													
6	18		17		16			15		14		13	
7													
8	19		20		21			22		23		24	
9													
10	30		29		28			27		26		25	
11													
12	31		32		33			34		35		36	
13													

NOTE: Not more than 4 corners, all in the same town and range, may be recorded on this certificate.

A. Description of original monument and accessories and/or subsequent restoration:

1. Post set by Hervey Parke in 1826.
2. Stone set for corner by Charles Eddy, County Surveyor, in November of 1898.
3. Stone recovered by Phillip Wetoskey, PS, in January, 1977 and recorded in Liber 02, Page 139. (Raised corner with 3/4" pipe and placed monument box.)

B. Description of corner evidence found and/or method applied in restoring or reestablishing corner:

Found 1" pipe in monument box, verified witnesses and set witness irons for replacement of monument after MDOT reconstruction of Price Road.

August, 1995 - Reset monument from witness irons and re-witnessed corner. Set Standard Clinton County Monument and carsonite marker.

The corner position is accepted as a careful and faithful perpetuation of the position of the original corner.

C. Description of monument for corner and accessories established to perpetuate locating the position of the corner:

South 1/4 Corner Section 3, T6N, R2W

- *Standard Clinton County Monument
- Physical Centerline of Road - South - 41'
- Nail & MDOT tag in W. side Wood Anchor Post - North - 28.62'
- Nail & tag #13039 in N. side Service Pole - N89°E - 300.62'
- Nail & tag #13039 in W. side Power Pole - S03°E - 237.10'
- Nail & tag #13039 in NW side Power Pole - S58°W - 406.17'


*Standard Clinton County Monument is a 2 1/2" dia. steel tube long with a stamped brass cap and a breakaway magnetic base.

Signed by Arden S. Pierson

Date September 19, 1995

Surveyor's Michigan License No. 13039

APPROVED BY
CLINTON COUNTY PEER GROUP
DATED 9/30/95
979

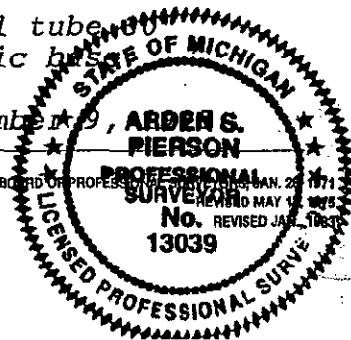

FORM APPROVED BY MICHIGAN STATE BOARD OF PROFESSIONAL SURVEYORS JAN. 28, 1971