

SURVEY &  
MONUMENTATION


JAN 17 1996  
REMONUMENTATION  
SECTION 2, OLIVE TOWNSHIP  
LAND CORNER RECORDATION CERTIFICATE  
Filing Requirement of Act 74, Mich. P.A. 1970

For corners in Clinton Located In: Corner Code #  
(County)

|                                      |   |           |   |           |            |
|--------------------------------------|---|-----------|---|-----------|------------|
| 1. Public Land Survey                | T | <u>6N</u> | R | <u>2W</u> | <u>I-3</u> |
|                                      | T |           | R |           |            |
|                                      | T |           | R |           |            |
|                                      | T |           | R |           |            |
| 2. Property Controlling in Section   | S |           | T |           | R          |
|                                      | S |           | T |           | R          |
| 3. Miscellaneous Property in Section | S |           | T |           | R          |
|                                      | S |           | T |           | R          |

RECORDED  
SEP 27 9 14 AM '95  
REGISTERED BY  
CLINTON COUNTY REGISTER  
*Carole M. ...*  
LIBER 4, PAGE 72  
Register of Deeds Stamp & File Number

4. Lot No. \_\_\_\_\_, Recorded Plat \_\_\_\_\_  
5. Private Claims \_\_\_\_\_

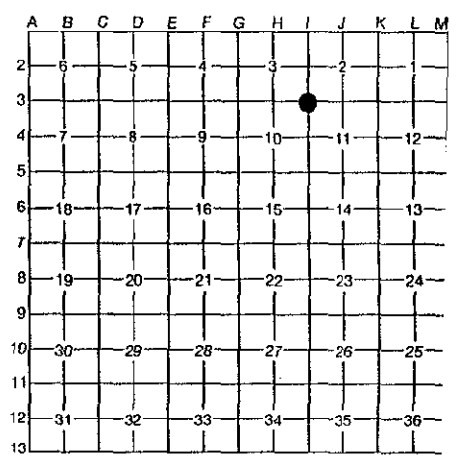

Arden S. Pierson P.S. in a field survey on August 1, 1995, do hereby certify that under requirements of P.A. 74, Michigan P.A. of 1970, the corner points mentioned in lines 1 and 2 above were in conformance with regulations and rules therefore as required in the current manual of survey instructions of the United States Department of the Interior, Bureau of Land Management or by a decree of a Court of Law and/or that the corner points mentioned in lines 3, 4 and 5 above were in conformance with the rules of the Michigan Board of Professional Surveyors or by a Decree of a Court of Law; established, re-established, monumented, re-monumented, recovered, found as expressed below:

NOTE: Not more than 4 corners, all in the same town and range, may be recorded on this certificate.

A. Description of original monument and accessories and/or subsequent restoration:  
**Original survey by Hervey Parke in 1827.** Sugar 10" - S31°E - 06 Links; W. Oak 16" - N72½°W - 23 Links  
**MDOT Survey Map - Job No. 05662 - 9/23/80 - Monument** Box with ½" rod 23" walnut - S70°W - 65.25'; Utility Pole - N20°W - 50.17'; wood fence corner post - N40°E - 41.57';  
**LCRC Liber 2, Page 799 - James Porter PS - 9/23/91 -** Found ½" iron in monument box - MDOT nail and tag in PP. - NW - 50.08'; MDOT nail and tag in 18" walnut - SE - 65.32'; steel sign post - NE - 38.25'; SW. Corner house - 19" foundation - NW - 104.97'.


B. Description of corner evidence found and/or method applied in restoring or reestablishing corner:  
  
Set offset irons to preserve corner position during MDOT reconstruction of Price Road, and re-witnessed corner.  
  
Reset corner from witness irons and witness objects.  
  
Set Standard Clinton County Monument and carsonite marker.  
  
The corner position is accepted as a careful and faithful perpetuation of the position of the original corner.

C. Description of monument for corner and accessories established to perpetuate locating the position of the corner:  
  
**SW Corner Section 2, Olive Township**  
\*Standard Clinton County Monument  
Physical Centerline of Road - South 71.3'  
Right of Way Fence - North - 36.7'  
Nail & MDOT tag in NE side 24" Box Elder - N57°W - 88.10'  
Nail & MDOT tag in NE side 30" Walnut - N43°W - 137.13'  
Nail & tag #13039 in S. side Power Pole - N85°E - 169.67'

\*Standard Clinton County Monument is a 2½" dia. steel tube 30" long with a stamped brass cap and a breakaway magnetic base

Signed by Arden S. Pierson Date September 9, 1995  
Surveyor's Michigan License No. 13039

APPROVED BY  
CLINTON COUNTY PEER GROUP  
DATED 8/30/95  
979

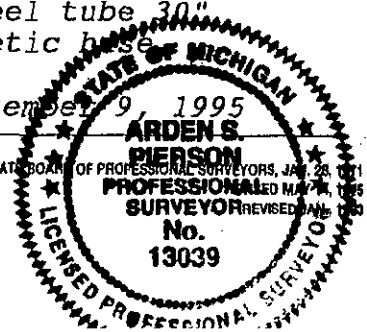

FORM APPROVED BY MICHIGAN STATE BOARD OF PROFESSIONAL SURVEYORS, JAN. 28, 1991