

SURVEY & REMONUMENTATION

FEB 02 1998

REMONUMENTATION OLIVE AND DEWITT TOWNSHIP LAND CORNER RECORDATION CERTIFICATE Filing Requirement of Act 74, Mich. P.A. 1970

LIBER 004 PAGE 202
RECORDED

SECTION For corners in

| | | |
|---------------------------------------|--|--------------------------------------|
| Clinton _____ (County) | Located in: | Corner Code # |
| 1. Public Land Survey | T_6N R_2W T_5N R_2W T_____ R_____ T_____ R_____ | <u>J-13</u> J-1 _____ _____ |
| 2. Property Controlling In Section | S_____ T_____ R_____ S_____ T_____ R_____ | _____ _____ |
| 3. Miscellaneous Property in Sec. | S_____ T_____ R_____ S_____ T_____ R_____ | _____ _____ |
| 4. Lot No. _____ | Recorded Plat _____ | |
| 5. Private Claims _____ | | |

Oct 17 9 17 AM '97

REGISTER OF DEEDS
CLINTON COUNTY, MICH.
Carole W. Wadley

Register of Deeds Stamp & File Number

| | A | B | C | D | E | F | G | H | I | J | K | L | M |
|----|----|----|----|----|----|----|---|---|---|---|---|---|---|
| 2 | 6 | 5 | 4 | 3 | 2 | 1 | | | | | | | |
| 3 | | | | | | | | | | | | | |
| 4 | 7 | 8 | 9 | 10 | 11 | 12 | | | | | | | |
| 5 | | | | | | | | | | | | | |
| 6 | 18 | 17 | 16 | 15 | 14 | 13 | | | | | | | |
| 7 | | | | | | | | | | | | | |
| 8 | 19 | 20 | 21 | 22 | 23 | 24 | | | | | | | |
| 9 | | | | | | | | | | | | | |
| 10 | 30 | 29 | 28 | 27 | 26 | 25 | | | | | | | |
| 11 | | | | | | | | | | | | | |
| 12 | 31 | 32 | 33 | 34 | 35 | 36 | | | | | | | |
| 13 | | | | | | | | | | | | | |

I, Mark L. VanRaemdonck, in a filed survey on August 21, 1997, do hereby certify that under requirements of P.A. 74, Michigan P.A. of 1970, the corner points mentioned in lines 1 and 2 above were in conformance with regulations and rules therefore as required in the current manual of survey instructions of the United States Department of the Interior, Bureau of Land Management or by a decree of a Court of Law and/or that the corner points mentioned in lines 3, 4 and 5 above were in conformance with the rules of the Michigan Board of Land Surveyors or by a Decree of a Court of Law; established, re-established, monumented, re-monumented, recovered, found as expressed below:

NOTE: Not more than 2 corners, all in the same town and range, may be recorded on this certificate.

A. Description of original monument and accessories and/or subsequent restoration:

- Original Lucius Lyons 1826
Mon: Wood Post
Access: B. Oak 14 N76°E 77
W Oak 18 N79°W 76
- County Surveyor Hollister Field Book 2, P. 157 Aug. 19-1899
Mon: Stone with stake below
Access: Cherry 10 N48°W 40
Hickory 15 N14°W 127 ½

(continued on reversed side of this sheet)

B. Description of corner evidence found and/or method applied in restoring or re-establishing corner:

Found 3/4" pipe with cap #20708 as referenced in No. 3 and 4 above. I accepted this location as the original corner position based on the best available evidence. Based on historical evidence and measurement capabilities of early surveyors. This corner has been used extensively in establishing boundaries in the area and to do otherwise would be disruptive to the area.


C. Description of monument for corner and accessories to perpetuate locating the position of the corner

Removed 3/4" pipe and replaced it with a STD Clinton County Remonumentation Monument. The monument is witnessed by the following accessories:

| | |
|----------------------|---|
| N05E 5.12' | Found P. K. & tag #39100 in W. side 24" Hickory |
| N05W 18.17' | M.D.O.T. reference tag in E. Face Util. Pole |
| North 46.60' | Centerline asphalt pavement Round Lake Road |
| S60E 42.08' | NW cor. house foundation |
| S80E 74.78' | Set Nail & Tag #24622 in N. face 10" Spruce |
| N89°43'15"W 2622.48' | STD Clinton County Mon at I-13, T6N-R2W |
| S89°41'17"E 2639.98' | STD Clinton County Mon at K-13, T6N-R2W |

Signed by *Mark L. VanRaemdonck*
Surveyor's Michigan License No. 24622

Date SEPT. 8, 1997

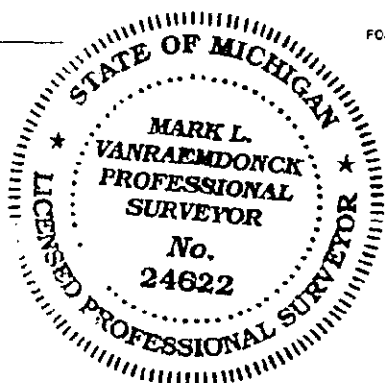

FORM APPROVED BY MICHIGAN STATE BOARD OF LAND SURVEYORS JULY 18, 1971
REVISED MAY 14, 1975
REVISED JAN. 1983

APPROVED BY
CLINTON COUNTY PEER GROUP
DATED 8/13/97

J. J. J.

197 0/1/1997

372
J. Fluke
J-1 T5N-R2W

A. Description of original monument and accessories and/or subsequent restoration:

(continued from front)

LIBER 004 PAGE 203

3. Edwin Morse L.C.R.C. L. 2, P. 313 April 1980
Mon: 3/4" X 30" pipe with R.L.S. Cap #20708
Access: N40°E 42.50' M.D.S.H. ref. tag in 30" box elder
North 18.50' M.D.S.H. ref. tag in tele. pole
S35°E 49.41' NW cor. of conc. patio
S60°E 42.13' NW cor. house foundation
N55°E 19.95' P.K. nail in conc. driveway

4. Kay Don Fluke, L.C.R.C. L. 2, P. 407 10/6/81
Mon: Found 3/4" X 30" pipe with R.L.S. cap #20708 (Rec. as J-1 T5N-R2W)
Access: N40°E 42.50' M.D.S.H. ref. tag in 30" box elder
North 18.50' M.D.S.H. ref. tag in tele. pole
S35°E 49.41' NW cor. of conc. patio
S60°E 42.13' NW cor. house foundation
N55°E 19.95' P.K. nail in conc. driveway
(Mr. Fluke declares corners J-1 T5N-R2W and J-13 T6N- R2W are common).