

DEC 07 1994

COMMISSION

LAND CORNER RECORDATION CERTIFICATE

Filing Requirement of Act 74, Mich. P.A. 1970

For corners in

<u>Clinton</u> (County)	Located In:	Corner Code #
1. Public Land Survey	T <u>6N</u> R <u>3W</u>	<u>E-5</u>
	T <u>6N</u> R <u>3W</u>	<u>F-5</u>
	T _____ R _____	_____
	T _____ R _____	_____
2. Property Controlling in Section	S _____ T _____ R _____	_____
	S _____ T _____ R _____	_____
3. Miscellaneous Property in Sec.	S _____ T _____ R _____	_____
	S _____ T _____ R _____	_____

RECORDED

LIBER 2, PAGE 879

SEP 23 8 35 AM '93

REGISTER OF DEEDS
CLINTON COUNTY, MICH.
Carol Woolley

Register of Deeds Stamp & File Number

4. Lot No. _____, Recorded Plat _____
5. Private Claims _____

I, Ronnie M. Lester, in a field survey on July 6, 1993, do hereby certify that under requirements of P.A. 74, Michigan P.A. of 1970, the corner points mentioned in lines 1 and 2 above were in conformance with regulations and rules therefore as required in the current manual of survey instructions of the United States Department of the Interior, Bureau of Land Management or by a decree of a Court of Law and/or that the corner points mentioned in lines 3, 4 and 5 above were in conformance with the rules of the Michigan Board of Land Surveyors or by a Decree of a Court of Law; established, re-established, monumented, re-monumented, recovered, found as expressed below:

A	B	C	D	E	F	G	H	I	J	K	L	M
2	6		6		4		3		2		1	
3												
4	7		8		9		10		11		12	
5												
6	18		17		16		15		14		13	
7												
8	19		20		21		22		23		24	
9												
10	30		29		28		27		26		25	
11												
12	31		32		33		34		35		36	
13												

NOTE: Not more than 4 corners, all in the same town and range, may be recorded on this certificate.

A. Description of original monument and accessories and/or subsequent restoration:

E-5, Northwest Corner Section 16. GLO records indicate corner set 40 chains North of 1/4 corner. Witnesses: Sugar 14" S55°W 11 links; Sugar 12" N39°E 36 links. County Surveyor notes of R.H. Colburn indicate "Set stone and broken crockery" No witnesses given. April 1886 recorded in Volume 1, Page 248. Vince McMahon calls for corner of 1/2" rod in Survey recorded in Liber 1, Page 929 of Clinton County Survey Records. Witnesses of: N60°E St. sign(no distance given); S32°E, F.P. 35.10; N30°W, MBT pole, 45'.

F-5, North 1/4 corner Section 16. GLO records indicate corner set 39.90 1/2 chains from adjacent section corners. Witnesses: Lynn 40" North .12; Beech 14" S19°E 13. County Surveyor notes of R.H. Colburn indicate "Set stone". Witnesses: elm 26" N44°W 248 1/2. Dave Clifford, PS #25837 indicates he excavated and found stone. He set 1/2" pipe and cap #25837.

B. Description of corner evidence found and/or method applied in restoring or reestablishing corner:


E-5 Investigation at this corner revealed a 1/2" bar in location indicated in Survey recorded in Liber 1, Page 929. Measured East 2633.89'(GLO 2633.73). Measured South 2637.86(GLO 2640.0). Accepted 1/2" bar as perpetuated location of Section corner.

F-5 Investigation at this corner revealed a 1/2" pipe and cap #25837 next to stone. Accepted pipe and cap as perpetuated location of section corner. Measured West 2633.89(GLO 2633.73) Measured East 2633.99(GLO 2633.73) Measured South 2641.23'(Co. Surveyor Record 2640.0)

C. Description of monument for corner and accessories established to perpetuate locating the position of the corner as described above:

E-5 1/2" bar in intersection of Jason and Forest Hill Roads as described above.
 Southwest corner concrete foundation, 33° az., 83.71'
 Southwest corner concrete foundation, 47° az., 78.81'
 Southwest corner concrete porch, 306° az., 116.61'
 Southwest corner concrete foundation frame barn, 87° az., 202.51'
 Found P.K. nail in S.W. side utility pole, 316° az., 44.91'

F-5 1/2" pipe and cap in Centerline of Jason road on occupation line North and South.
 Found nail and tag #25837 in East side 6" cherry, 05° az., 47.01'
 Found nail and tag #25837 in top of post, 332° az., 40.1'
 Set nail and tag #18998 in South side 20" maple, 92° az., 231.31'
 Centerline of West end 12" C.M.P., 21° az., 16.2'
 Centerline of East end 12" C.M.P., 306° az., 30.1'

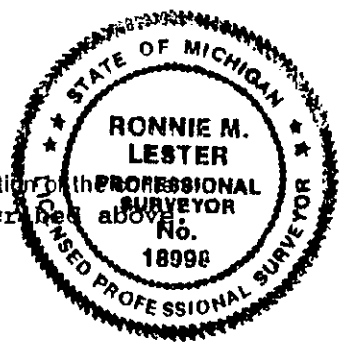

Signed by Ronnie M. Lester Date July 21, 1993

Surveyor's Michigan License No. 18998

APPROVED BY CLINTON COUNTY DEED GROUP
 DATED 8/17/93
J. 78