

JAN 17 1996

REMONUMENTATION SECTION 9, WESTPHALIA TOWNSHIP

COMMISSION LAND CORNER RECORDATION CERTIFICATE

Filing Requirement of Act 74, Mich. P.A. 1970

RECORDED

For corners in Clinton (County)

Located In:

Corner Code #

Table with 3 columns: Description, Located In (T, R, S), and Corner Code #. Includes rows for Public Land Survey, Property Controlling, and Miscellaneous Property.


Dec 19 2 50 PM '95

REGISTER OF DEEDS CLINTON COUNTY MICH.

LIBER 4, PAGE 118

Register of Deeds Stamp & File Number

- 4. Lot No.
5. Private Claims

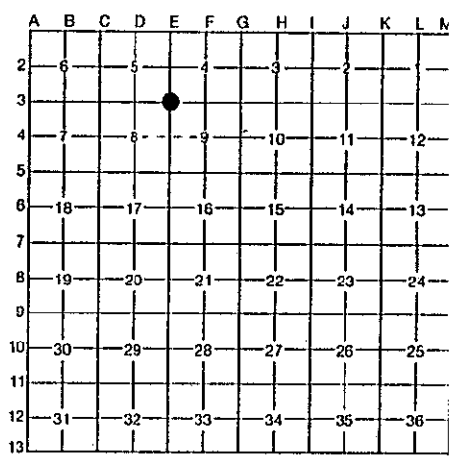

Arden S. Pierson P.S. in a field survey on October 27, 1995, do hereby certify that under requirements of P.A. 74, Michigan P.A. of 1970, the corner points mentioned in lines 1 and 2 above were in conformance with regulations and rules...

NOTE: Not more than 4 corners, all in the same town and range, may be recorded on this certificate.

A. Description of original monument and accessories and/or subsequent restoration:

Original survey performed by Lucius Lyon DS 1827, set - 79.87 chains Section Corner. Corner shown on Westphalia Amended Plats I, II, III, and IV (by Chas E. Hollister in 1893).

(OVER)

B. Description of corner evidence found and/or method applied in restoring or reestablishing corner:

Section Corner common to Sections 4, 5, 8 and 9, T6N, R4W. Found 1/2" rod and cap in monument box. Removed rod and monument box. Found "T" iron down 2.5'. Drove "T" iron down and set Standard Clinton County Monument and monument box. Accepted 1/2" rod and cap in monument box as a careful and faithful perpetuation of the position of the original corner.

APPROVED BY CLINTON COUNTY P.E.R. GROUP DATED 11/8/95



C. Description of monument for corner and accessories established to perpetuate locating the position of the corner:

- NW Corner, Section 9
\*Standard Clinton County Monument in monument box
SE Corner Block Building - N75°E - 129.33'
SW Corner Building Foundation - N46°E - 54.05'
SE Corner Building - N41°W - 54.40'
NE Corner Brick Building - S45°W - 50.50'

\*Standard Clinton County Monument is a 2 1/2" dia. steel tube 30" long with a stamped brass cap and a breakaway magnetic base.

Signed by Arden S. Pierson

Date November 4, 1995

Surveyor's Michigan License No. 13039

**Certified Boundary Survey - Fred White Engineering - Page 118,  
Liber 1, dated July 15, 1972, by Ron Helsel #18994.**

**Certified Boundary Survey - Kay Don Fluke #18988, Page 135,  
Liber 1, dated June 6, 1972.**

Found 1- $\frac{1}{4}$ " pipe in monument box.  
N45°W - 42.45' - TP & PP  
N58°E - 43.67' - TP & PP  
S50°E - 61.10' - (8" Steel) Tel. Guy Pole  
S55°W - 43.59' - TP & PP

**LCRC by Kay Don Fluke #18988, Page 367, Liber 001, dated  
June 26, 1972.**

Found 1- $\frac{1}{4}$ " pipe in monument box.  
N45°W - 42.45' - TP & PP  
N58°E - 43.67' - TP & PP  
S50°E - 61.10' - (8" Steel) Tel. Guy Pole  
S55°W - 43.59' - TP & PP

**LCRC by Fred White #12034, Page 497, Liber 1, dated October 25, 1972.**

Found 1/2" iron bar in monument box.  
N50°W - 42.42' - Power Pole  
N45°E - 43.64' - Power Pole  
SW - 50.43' - NW Corner Building  
S50°W - 43.55' - Power Pole  
N45°W - 48.28' - SE Corner Plines Bavarian Inn

**Certified Boundary Survey by Fred White Engineering, Page 579, Liber  
01, dated November 2, 1974, by Ron Helsel #18994**

SW Corner Rec. Liber 1, Page 497.

**Certified Boundary Survey by Fred White Engineering, Page 580, Liber  
01, dated November 2, 1974 by Ron Helsel #18994.**

SW Corner Rec. Liber 1, Page 497

**Clinton County Road Commission alignment field notes related to U.S.  
Public Land Survey Corners. Page 41, date: 1920+/-.**

Record Book - L.L. Budd, Westphalia Township, T6N, R4W  
1" gal. iron pipe 4" down witnessed by 3 - 1" gal. iron pipes.

3/4" pipe - N36°20'W - 43.00'  
3/4" pipe - N38°20'E - 43.00'  
3/4" pipe - S42°50'E - 37.00'

E-3: Section Corner Common to Sections 4, 5, 8, & 9, T6N, R4W  
3" iron pipe, 2" down.  
Witnessed by (2) 3/4" iron pipes.