

**REMONUMENTATION**  
**SECTION 9, WESTPHALIA TOWNSHIP**  
**LAND CORNER RECORDATION CERTIFICATE**  
 Filing Requirement of Act 74, Mich. P.A. 1970

JAN 17 1996

RECORDED

For corners in  
Clinton  
 (County)

Located In:

Corner Code #

- |   |   |           |   |           |            |
|---|---|-----------|---|-----------|------------|
| 1. Public Land Survey                   | T | <u>6N</u> | R | <u>4W</u> | <u>E-5</u> |
|   | T |           | R |           |            |
|   | T |           | R |           |            |
|   | T |           | R |           |            |
| 2. Property Controlling<br>in Section   | S |           | T |           | R          |
|   | S |           | T |           | R          |
| 3. Miscellaneous<br>Property in Section | S |           | T |           | R          |
|   | S |           | T |           | R          |

DEC 19 2 49 PM '95

REGISTER OF DEEDS  
 CLINTON COUNTY, MICH.  
*Arden S. Pierson*

LIBER 4, PAGE 106

Register of Deeds Stamp & File Number

4. Lot No. \_\_\_\_\_, Recorded Plat \_\_\_\_\_  
 5. Private Claims \_\_\_\_\_

|    | A  | B | C | D  | E | F  | G | H  | I | J  | K | L  | M |
|----|----|---|---|----|---|----|---|----|---|----|---|----|---|
| 2  | 6  |   |   | 5  |   | 4  |   | 3  |   | 2  |   |    |   |
| 3  |    |   |   |    |   |    |   |    |   |    |   |    |   |
| 4  | 7  |   |   | 8  |   | 9  |   | 10 |   | 11 |   | 12 |   |
| 5  |    |   |   |    |   |    |   |    |   |    |   |    |   |
| 6  | 18 |   |   | 17 |   | 16 |   | 15 |   | 14 |   | 13 |   |
| 7  |    |   |   |    |   |    |   |    |   |    |   |    |   |
| 8  | 19 |   |   | 20 |   | 21 |   | 22 |   | 23 |   | 24 |   |
| 9  |    |   |   |    |   |    |   |    |   |    |   |    |   |
| 10 | 30 |   |   | 29 |   | 28 |   | 27 |   | 26 |   | 25 |   |
| 11 |    |   |   |    |   |    |   |    |   |    |   |    |   |
| 12 | 31 |   |   | 32 |   | 33 |   | 34 |   | 35 |   | 36 |   |
| 13 |    |   |   |    |   |    |   |    |   |    |   |    |   |

Arden S. Pierson P.S., in a field survey on October 13, 1995, do hereby certify that under requirements of P.A. 74, Michigan P.A. of 1970, the corner points mentioned in lines 1 and 2 above were in conformance with regulations and rules therefore as required in the current manual of survey instructions of the United States Department of the Interior, Bureau of Land Management or by a decree of a Court of Law and/or that the corner points mentioned in lines 3, 4 and 5 above were in conformance with the rules of the Michigan Board of Professional Surveyors or by a Decree of a Court of Law; established, re-established, monumented, re-monumented, recovered, found as expressed below:

NOTE: Not more than 4 corners, all in the same town and range, may be recorded on this certificate.

A. Description of original monument and accessories and/or subsequent restoration:

Original survey performed by Lucius Lyon, DS, in 1827.  
 80.00 chains - SW Post Corner to Sections 8, 9, 16 & 17  
 10" Beech - S11°E - 9 links  
 22" Maple - S59°W - 21 links


(OVER)

B. Description of corner evidence found and/or method applied in restoring or reestablishing corner:

Found 5/8" rod in monument box. Removed 5/8" rod, monument box and 3 rings. Found railroad spike over pointed stone. Accepted 5/8" rod as a careful and faithful perpetuation of the position of the original corner.

Set Standard Clinton County Monument and monument box.

APPROVED BY  
 CLINTON COUNTY PEER GROUP  
 DATED 10/18/95  
*J. J. J.*

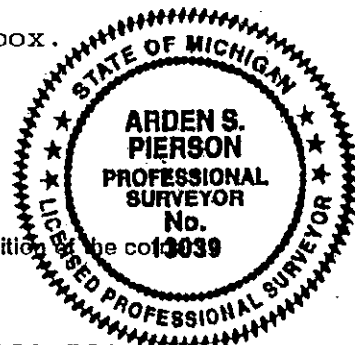

C. Description of monument for corner and accessories established to perpetuate locating the position:

SW Corner, Section 9

- \*Standard Clinton County Monument in monument box
- Nail & tag #13039 in SE Side Power Pole - N21°E - 132.58'
- Nail & tag #13039 in SW Side Power Pole - S46°E - 46.77'
- Nail & tag #13039 in NE Side Telephone Pole Stub - S31°E - 66.02'
- \*\*NE Corner House Foundation - S46°W - 128.24'

\*Standard Clinton County Monument is a 2½" dia. steel tube 30" long with a stamped brass cap and a breakaway magnetic base.  
 \*\*County Surveyor Witness Object.

Signed by *Arden S. Pierson*

Date October 28, 1995

Surveyor's Michigan License No. 13039

County Surveyor notes by Charles Eddy (1891 --1902). NE  
Corner of Section 17 common to SW Corner of Section 9,  
Westphalia Township.

Found stone.

S43- $\frac{1}{2}$ °W - 195 links (128.70') - NE Corner of House

N85- $\frac{1}{2}$ °E - 523 links (345.18') - 12" Elm

Clinton County Road Commission Alignment Field Notes related  
to U.S. Public Land Survey Corners (1920 +/-).

E-5: 26 + 33.3 Section Corner Common to Sections 8, 9, 16 & 17.  
Flat topped stone 3" below surface of road.  
Cross cut in top.

Witnessed: 3 - 1" gal. iron pipes. Deflection 0°-2' left