

REMONUMENTATION
JAN 17 1996 SECTION 20, WESTPHALIA TOWNSHIP
 LAND CORNER RECORDATION CERTIFICATE
COMMISSION Filing Requirement of Act 74, Mich. P.A. 1970

RECORDED

For corners in Clinton (County) Located In: Corner Code #

1. Public Land Survey	T	<u>6N</u>	R	<u>4W</u>	<u>E-8</u>
	T	_____	R	_____	_____
	T	_____	R	_____	_____
	T	_____	R	_____	_____
2. Property Controlling In Section	S	_____	T	_____	_____
	S	_____	T	_____	_____
3. Miscellaneous Property In Section	S	_____	T	_____	_____
	S	_____	T	_____	_____

4. Lot No. _____, Recorded Plat _____

5. Private Claims _____

DEC 19 2 51 PM '95

RECORDED BY: _____
 CLINTON COUNTY, MICH.
Arden S. Pierson

LIBER 4, PAGE 124

Register of Deeds Stamp & File Number

Arden S. Pierson P.S. in a field survey on November 3, 1995, do hereby certify that under requirements of P.A. 74, Michigan P.A. of 1970, the corner points mentioned in lines 1 and 2 above were in conformance with regulations and rules therefore as required in the current manual of survey instructions of the United States Department of the Interior, Bureau of Land Management or by a decree of a Court of Law and/or that the corner points mentioned in lines 3, 4 and 5 above were in conformance with the rules of the Michigan Board of Professional Surveyors or by a Decree of a Court of Law; established, re-established, monumented, re-monumented, recovered, found as expressed below:

	A	B	C	D	E	F	G	H	I	J	K	L	M

NOTE: Not more than 4 corners, all in the same town and range, may be recorded on this certificate.

A. Description of original monument and accessories and/or subsequent restoration:

GLO Notes, survey by Lucius Lyon, D.S., in 1827. Set Half Mile Post 10" Sugar - S48°E - 21 links; 9" Beech - S83°W - 16 links.

County Surveyor Notes by R. H. Colburn, County Surveyor, in 1886. Found old stump Red Oak (18" when taken) now 36". Proved at point and set stone, R. Oak stump 36" - N52°W - 52 links.


(OVER)

B. Description of corner evidence found and/or method applied in restoring or reestablishing corner:

Found RR spike 4.8' west of road centerline and in line with fence east, verified 1975 witnesses by Clinton County Road Commission. Accepted RR spike as a careful and faithful perpetuation of the position of the original corner.

Set Standard Clinton County Monument and monument box.

APPROVED BY
 CLINTON COUNTY PEER GROUP
 DATED 11/8/95
J.P.

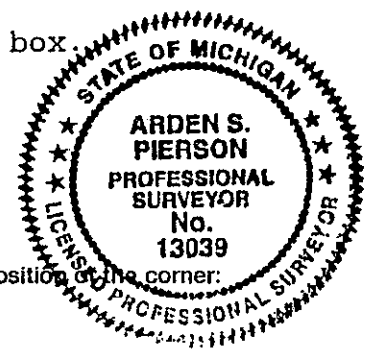

C. Description of monument for corner and accessories established to perpetuate locating the position of the corner:

1/4 Corner Common to Sections 20 & 21

- *Standard Clinton County Monument in monument box
- Face Top 2" Diameter Metal Anchor Post - N87°W - 27.55'
- Nail & tag #13039 in NW Side 10" Elm - S42°W - 45.62'
- Nail & tag #13039 in S. Side Wood Anchor Post - N90°E - 37.93'
- Nail & tag #13039 in SE Side Power Pole - N43°E - 171.27'

*Standard Clinton County Monument is a 2 1/2" dia. steel tube 30" long with a stamped brass cap and a breakaway magnetic base.

Signed by Arden S. Pierson Date November 4, 1995

Surveyor's Michigan License No. 13039

1920+/- Clinton County Road Commission Alignment Field Notes
of Public Land Corners, stone, 15" Elm - N22°30'E - 70.7';
12" Elm - S48°30'W - 30.0'; Fence Post - N86°30'E - 25.2'.

Clinton County Road Commission Field Notes 5/28/75 -- Found 3 sided
stone, 8" on each side, 1' deep in clay, in line with fence line.
Left in place and placed R.R. spike on top 6" below road surface.
Witnesses:

2-½" Iron Fence Post - West - 27.35'
P.K. Nail in Wood Fence Post - East - 37.77'
P.K. Nail in Telephone Pole - S45°W - 61.70'

10-10-75

Set a R.R. spike flush with top of pavement, 4.8' west of
centerline pavement.