

JAN 17 1996

REMONUMENTATION  
SECTION 20, WESTPHALIA TOWNSHIP  
LAND CORNER RECORDATION CERTIFICATE  
Filing Requirement of Act 74, Mich. P.A. 1970

RECORDED

Nov 9 9 04 AM '95

REGISTER OF DEEDS  
CLINTON COUNTY, MICH.  
*Carol Worley*

LIBER 4, PAGE 105

Register of Deeds Stamp & File Number

For corners in	Located In:	Corner Code #
Clinton (County)		
1. Public Land Survey	T <u>6N</u> R <u>4W</u>	E-9
	T _____ R _____	_____
	T _____ R _____	_____
	T _____ R _____	_____
2. Property Controlling In Section	S _____ T _____ R _____	_____
	S _____ T _____ R _____	_____
3. Miscellaneous Property in Section	S _____ T _____ R _____	_____
	S _____ T _____ R _____	_____
4. Lot No. _____, Recorded Plat _____		
5. Private Claims _____		

	A	B	C	D	E	F	G	H	I	J	K	L	M
2	6			5					3		2		
3													
4	7			8		9		10		11		12	
5													
6	16			17		18		15		14		13	
7													
8	19			20		21		22		23		24	
9													
10	30			29		28		27		26		25	
11													
12	31			32		33		34		35		36	
13													

Arden S. Pierson P.S., in a field survey on October 13, 1995, do hereby certify that under requirements of P.A. 74, Michigan P.A. of 1970, the corner points mentioned in lines 1 and 2 above were in conformance with regulations and rules therefore as required in the current manual of survey instructions of the United States Department of the Interior, Bureau of Land Management or by a decree of a Court of Law and/or that the corner points mentioned in lines 3, 4 and 5 above were in conformance with the rules of the Michigan Board of Professional Surveyors or by a Decree of a Court of Law; established, re-established, monumented, re-monumented, recovered, found as expressed below:

NOTE: Not more than 4 corners, all in the same town and range, may be recorded on this certificate.

A. Description of original monument and accessories and/or subsequent restoration:

GLO Notes, survey by Lucius Lyon, D.S., in 1827. Set Post in Swamp Corner to Sections 20, 21, 28 and 29, 12" Tamarack - S20°W - 38 links; 9" Tamarack - S85°E - 48 links.

County Surveyor Notes by R. H. Colburn, County Surveyor, in 1886. Found old original witness being a Tamarack stump and set stone at intersection. Poplar 8" S76°30'E - 69-1/2 links.

1920 Clinton County Road Commission Alignment Field Notes of Public Land Corners, stone 2" above ground, 24" Double Stump - S18°W - 93.3'; 4" Elm - N32°E - 40.3'; Corner Fence Post - S46°E - 32.0'.

B. Description of corner evidence found and/or method applied in restoring or reestablishing corner:

Found 2 monument box rings with nothing inside. Removed rings and found monument box 10" South with 5/8" rod - removed box and found 3/4" galvanized pipe below 5/8" rod -- did not find stone (dug 3.7' deep). Accepted 5/8" rod as a careful and faithful perpetuation of the position of the original corner.


Set Standard Clinton County Monument and monument box.

C. Description of monument for corner and accessories established to perpetuate locating the position of the corner:

**SE Corner, Section 20**

- \*Standard Clinton County Monument in monument box
- Nail & tag #13039 in NE Side Power Pole - S56°E - 142.25'
- Nail & tag #13039 in South Side Power Pole - N83°E - 142.02'
- Nail & tag #13039 in NW Side Power Pole - S31°W - 75.99'
- Nail & tag #13039 in SW Side Power Pole - N67°W - 95.70'

\*Standard Clinton County Monument is a 2 1/2" dia. steel tube 30" long with a stamped brass cap and a breakaway magnetic base.

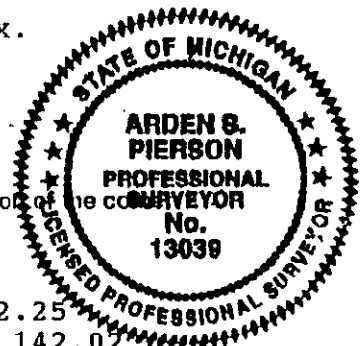

Signed by Arden S. Pierson

Date October 16, 1995

Surveyor's Michigan License No. 13039

APPROVED BY  
CLINTON COUNTY PEER GROUP  
DATED 10/18/95

*10/18/95*  
*A. Pierson*