

M 13 - T7N - R2W - BINGHAM TWP (RECORD # 24)

SURVEY & RECORDATION

NE CORNER OF SECTION 1, OLIVE TWP.

FEB 22 1936

LAND CORNER RECORDATION CERTIFICATE
Filing Requirement of Act 74, Mich. P.A. 1970

COMMISSION
RECORDED

For corners in
Clinton
(County)

Located In: Corner Code #

LIBER 4, PAGE 51

Dec 12 12 00 PM '94

REGISTERED CLINTON COUNTY RECORDS
Arden S. Pierson

Register of Deeds Stamp & File Number

- 1. Public Land Survey T 6N R 2W M-1
T 7N R 2W **M-13**
T _____ R _____
- 2. Property Controlling in Section S _____ T _____ R _____
S _____ T _____ R _____
- 3. Miscellaneous Property in Sec. S _____ T _____ R _____
S _____ T _____ R _____

- 4. Lot No. _____, Recorded Plat _____
- 5. Private Claims _____

	A	B	C	D	E	F	G	H	I	J	K	L	M
2	6	5	4	3	2	1							
3													
4	7	8	9	10	11	12							
5													
6	18	17	16	15	14	13							
7													
8	19	20	21	22	23	24							
9													
10	30	29	28	27	26	25							
11													
12	31	32	33	34	35	36							
13													

Arden S. Pierson PS, in a field survey on March 14, 19 94, do hereby certify that under requirements of P.A. 74, Michigan P.A. of 1970, the corner points mentioned in lines 1 and 2 above were in conformance with regulations and rules therefore as required in the current manual of survey instructions of the United States Department of the Interior, Bureau of Land Management or by a decree of a Court of Law and/or that the corner points mentioned in lines 3, 4 and 5 above were in conformance with the rules of the Michigan Board of Land Surveyors or by a Decree of a Court of Law; established, re-established, monumented, re-monumented, recovered, found as expressed below:

NOTE: Not more than 4 corners, all in the same town and range, may be recorded on this certificate.

A. Description of original monument and accessories and/or subsequent restoration:

M-1 - Original survey by Harvey Parke DS, 1826. Recorded in Liber 2, page 580, by Mark VanRaemdonck PS #24622, dated June 13, 1986. "Found 1/2" pipe at approx. C.L. intersection of Chandler Rd. and Centerline Road." (Did not witness) Used in survey dated 2-22-92.

APPROVED BY
CLINTON COUNTY PEER GROUP
DATED 11/9/94
S. J. S.

B. Description of corner evidence found and/or method applied in restoring or reestablishing corner:

Section 1, Olive Township

M-1 - Found 1/2" pipe in monument box buried 3". Accepted pipe as careful and faithful perpetuation of the position of the original corner. Dug down and removed pipe and monument box, the pipe was connected to a 1/2" iron and another 1/2" pipe 4 feet long total. Set Standard Clinton County Monument in new monument box. (This corner is common to the following townships, Olive, Bingham, Ovid and Victor.)

T6N R2W REC #67


C. Description of monument for corner and accessories established to perpetuate locating the position of the corner

M-1 (NE corner Section 1)
Clinton County Monument in mon. box

- PK nail & tag in N. side power pole -S75°E- 168.81'
- PK nail & tag in NE side wood sign post -N35°W- 47.45'
- PK nail & tag in SW side wood sign post -N42°W- 51.52'
- South edge Stop/Road sign post -N68°E- 38.72'

*Standard Clinton County Monument is a 2 1/2" dia. steel tube 30" long with a stamped brass cap and breakaway magnetic base.

Signed by Arden S. Pierson Date November 1, 1994
Surveyor's Michigan License No. 13039

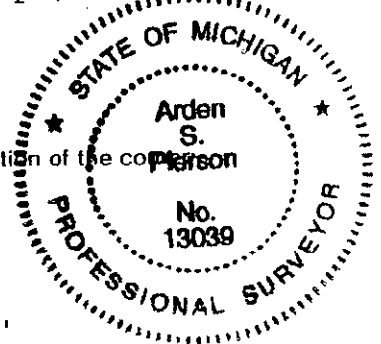

Olive M1 #67