

REMONUMENTATION

REMONUMENTATION SECTION 14, BINGHAM TOWNSHIP

JAN 17 1996

LAND CORNER RECORDATION CERTIFICATE

RECORDED

For corners in COMMISSION Clinton (County)

Located In:

Corner Code #

- 1. Public Land Survey T 7N R 2W I-7
2. Property Controlling in Section S T R
3. Miscellaneous Property in Section S T R

SEP 27 9 14 AM '95

REGISTERED DEEDS CLINTON COUNTY MICH

Carrie M. ...

LIBER 4, PAGE 75

Register of Deeds Stamp & File Number

- 4. Lot No. , Recorded Plat
5. Private Claims

Arden S. Pierson P.S. in a field survey on August 25, 1995 do hereby certify that under requirements of P.A. 74, Michigan P.A. of 1970, the corner points mentioned in lines 1 and 2 above were in conformance with regulations and rules therefore as required in the current manual of survey instructions of the United States Department of the Interior, Bureau of Land Management or by a decree of a Court of Law and/or that the corner points mentioned in lines 3, 4 and 5 above were in conformance with the rules of the Michigan Board of Professional Surveyors or by a Decree of a Court of Law; established, re-established, monumented, re-monumented, recovered, found as expressed below:

NOTE: Not more than 4 corners, all in the same town and range, may be recorded on this certificate.

A. Description of original monument and accessories and/or subsequent restoration: Original survey by C.W. Christmas in 1831.

County surveyor notes for Section 15 by Henry H. Jenison, dated June 16, 1881. Shows corner position, but no description or witness - survey by Chas. E. Hollister, dated August, 1880 - found original bearing tree stump and set a stone from which. W. Ash 5" - S48°W - 58 links and R. Oak 8" - N 79°E 230 links.

(OVER)

B. Description of corner evidence found and/or method applied in restoring or reestablishing corner:

Found 1/2" iron & cap in monument box. Excavated to set standard Clinton County monument and found stone with chiseled "x". The stone was accepted as a careful and faithful perpetuation of the position of the original corner.

C. Description of monument for corner and accessories established to perpetuate locating the position of the corner:

SW Corner, Section 14

*Standard Clinton County Monument in monument box.

- Nail & tag in W. side Power Pole - N01°E - 59.28'
Nail & tag in W. side Power Pole - S04°E - 202.91'
SE corner house foundation - N33°W - 185.90'
NE corner house foundation - N27°W - 206.68'

*Standard Clinton County Monument is a 2 1/2" dia. steel tube 30" long with a stamped brass cap and a breakaway magnetic base.


Signed by Arden S. Pierson

Date September 27, 1995

Surveyor's Michigan License No. 13039

FORM APPROVED BY MICHIGAN STATE BOARD OF PROFESSIONAL SURVEYORS

APPROVED BY CLINTON COUNTY PEER GROUP DATED 8/30/95

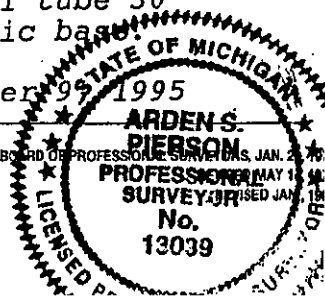

Grid table with columns A-K and rows 2-13. A dot is marked at the intersection of column H and row 7.