

CLINTON COUNTY REGISTER & COMMISSION

NW CORNER OF SECTION 6, WESTPHALIA TOWNSHIP

LAND CORNER RECORDATION CERTIFICATE  
Filing Requirement of Act 74, Mich. P.A. 1970

FEB 22 1996

RECORDATION COMMISSION

For corners in  
Clinton  
(County)

Located In: Corner Code //

LIBER 4, PAGE 63

Dec 12 3 36 PM '94

REGISTERED CLINTON COUNTY, MICH.

*Arden S. Pierson*

Register of Deeds Stamp & File Number

- 1. Public Land Survey T 6N R 4W A-1  
T \_\_\_\_\_ R \_\_\_\_\_  
T 7N R 4W A-13  
T \_\_\_\_\_ R \_\_\_\_\_
- 2. Property Controlling S \_\_\_\_\_ T \_\_\_\_\_ R \_\_\_\_\_  
in Section S \_\_\_\_\_ T \_\_\_\_\_ R \_\_\_\_\_
- 3. Miscellaneous S \_\_\_\_\_ T \_\_\_\_\_ R \_\_\_\_\_  
Property in Sec. S \_\_\_\_\_ T \_\_\_\_\_ R \_\_\_\_\_
- 4. Lot No. \_\_\_\_\_, Recorded Plat \_\_\_\_\_
- 5. Private Claims \_\_\_\_\_

|    | A  | B | C  | D | E  | F | G  | H | I  | J | K  | L | M |
|----|----|---|----|---|----|---|----|---|----|---|----|---|---|
| 2  | 6  |   | 5  |   | 4  |   | 3  |   | 2  |   | 1  |   |   |
| 3  |    |   |    |   |    |   |    |   |    |   |    |   |   |
| 4  | 7  |   | 8  |   | 9  |   | 10 |   | 11 |   | 12 |   |   |
| 5  |    |   |    |   |    |   |    |   |    |   |    |   |   |
| 6  | 18 |   | 17 |   | 16 |   | 15 |   | 14 |   | 13 |   |   |
| 7  |    |   |    |   |    |   |    |   |    |   |    |   |   |
| 8  | 19 |   | 20 |   | 21 |   | 22 |   | 23 |   | 24 |   |   |
| 9  |    |   |    |   |    |   |    |   |    |   |    |   |   |
| 10 | 30 |   | 29 |   | 28 |   | 27 |   | 26 |   | 25 |   |   |
| 11 |    |   |    |   |    |   |    |   |    |   |    |   |   |
| 12 | 31 |   | 32 |   | 33 |   | 34 |   | 35 |   | 36 |   |   |
| 13 |    |   |    |   |    |   |    |   |    |   |    |   |   |

Arden S. Pierson PS, in a field survey on March 9, 19 94 do hereby certify that under requirements of P.A. 74, Michigan P.A. of 1970, the corner points mentioned in lines 1 and 2 above were in conformance with regulations and rules therefore as required in the current manual of survey instructions of the United States Department of the Interior, Bureau of Land Management or by a decree of a Court of Law and/or that the corner points mentioned in lines 3, 4 and 5 above were in conformance with the rules of the Michigan Board of Land Surveyors or by a Decree of a Court of Law; established, re-established, monumented, re-monumented, recovered, found as expressed below:

NOTE: Not more than 4 corners, all in the same town and range, may be recorded on this certificate.

A. Description of original monument and accessories and/or subsequent restoration:

A-1 - Original survey by Lucius Lyon DS, 1827. Iona Road Commission Witness sheet indicated corner is a fireclay monument. (Portland Twp. map)

APPROVED BY  
CLINTON COUNTY PEER GROUP  
DATED 12/7/94  
*JFS*

B. Description of corner evidence found and/or method applied in restoring or reestablishing corner:

Section 6, Westphalia Township


A-1 - Found reading with schonstedt in centerline of Clintonia and Centerline Roads - November 3, 1994, Observed Excavation by Clinton County Road Commission - Excavated 4'x 4' area 4' deep at Schonstedt reading, found boatspike on a fireclay cylinder surrounded by stones. Accepted clay cylinder as a careful and faithful perpetuation of the position of the original corner. Placed Standard Clinton County Monument and monument box.

C. Description of monument for corner and accessories established to perpetuate locating the position of the corner:

A-1 (NW corner of Section 6)  
Clinton County Monument

- Nail & tag #13039 NE side 38" Maple -N22°W- 54.51'
- Nail & tag #13039 NW side anchor post -S44°W- 45.31'
- Nail & tag #13039 NE side utility pole -S27°E- 54.98'
- Nail & tag #13039 SE side tel.box marker pole -N55°E- 52.09'

\*Standard Clinton County Monument is a 2½" dia. steel tube 30" long with a stamped brass cap and breakaway magnetic base.

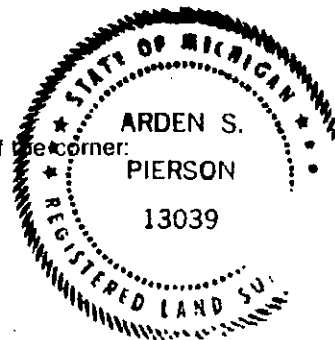

Signed by *Arden S. Pierson*

November 1, 1994

Surveyor's Michigan License No. 13039