SURVEY & REMONUMENTATION

DEC 07 1994

COMMISSION

RECORDED

JAN 24 9 46 AM '94

REGISTER OF DEEDS
CLINTON COUNTY, MICH.
Carol Wooley

LIBER 4, PAGE 7

Register of Deeds Stamp & File Number

LAND CORNER RECORDATION CERTIFICATE

Filing Requirement of Act 74, Mich. P.A. 1970

For corners in Clinton (County)

	Located In:		Corner Code #:
	7N	4W	I-13, J-13
1. Public Land Survey	T ___	R ___	
	T ___	R ___	
	T ___	R ___	
	T ___	R ___	
2. Property Controlling	S ___ T ___	R ___	
in Section	S ___ T ___	R ___	
3. Miscellaneous	S ___ T ___	R ___	
Property in Sec.	S ___ T ___	R ___	

4. Lot No. _____, Recorded Plat _____
5. Private Claims _____

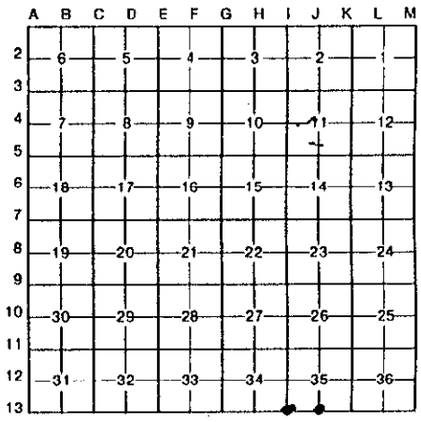

Arden S. Pierson P.S. October 18 93

I, _____, in a field survey on _____, 19 ____, do hereby certify that under requirements of P.A. 74, Michigan P.A. of 1970, the corner points mentioned in lines 1 and 2 above were in conformance with regulations and rules therefore as required in the current manual of survey instructions of the United States Department of the Interior, Bureau of Land Management or by a decree of a Court of Law and/or that the corner points mentioned in lines 3, 4 and 5 above were in conformance with the rules of the Michigan Board of Land Surveyors or by a Decree of a Court of Law; established, re-established, monumented, re-monumented, recovered, found as expressed below:

NOTE: Not more than 4 corners, all in the same town and range, may be recorded on this certificate.

A. Description of original monument and accessories and/or subsequent restoration:

I-13 - County Surveyor notes- Chas E. Hollister Deputy Surveyor, March, 1894,- Set large stone with crockery around it.

J-13 - County Surveyor notes- Chas E. Hollister Deputy Surveyor, March, 1894,- Post for Quarter post

B. Description of corner evidence found and/or method applied in restoring or reestablishing corner:

Section 35, Dallas Township

I-13 (SW corner) - Intersection Centerline Rd. & Tallman Rd. North- found large pointed stone with crockery & tile buried 18"-Moved stone - Set Standard Clinton County Monument.(Buried 8")

J-13 (S ¼ corner) - Found large pointed stone & crockery - Removed stone - Set Standard Clinton County Monument.(Buried 8")

C. Description of monument for corner and accessories established to perpetuate locating the position of the corner:

I-13 (SW corner)	J-13 (S ¼ corner)
(Standard Clinton County Monument-buried 8")	(Standard Clinton County Monument-buried 8")
N & T NE side wood anchor post -N37°W- 37.58'	N & T E. side wood anchor post -North- 25.23'
N & T NW side wood fence post -N41°E- 39.75'	N & T E. side wood fence post -N33°E- 27.60'
NE corner concrete anchor post -S05°E- 30.95'	SW corner telephone riser box -N70°E- 61.25'
N & T NE side power pole -S57°E- 79.62'	N & T NE side wood anchor post -S24°E- 35.81'

*Standard Clinton County Monument is a 2" steel tube, 30" long with a 3½" breakaway magnetic base and stamped brass cap.

Signed by Arden S. Pierson Date NOVEMBER 17, 1993

Surveyor's Michigan License No. 13039

APPROVED BY
CLINTON COUNTY PEER GROUP
DATED 12/8/93

FORM APPROVED BY MICHIGAN STATE BOARD OF LAND SURVEYORS, JAN. 28, 1971
REVISED MAY 14, 1975
REVISED JAN., 1983