SURVEY & REMONUMENTATION

DEC 07 1994

COMMISSION

LAND CORNER RECORDATION CERTIFICATE

Filing Requirement of Act 74, Mich. P.A. 1970

RECORDED

JAN 24 9 46 AM '94

REGISTER OF DEEDS
CLINTON COUNTY, MICH.
Carol Wooley

LIBER 4, PAGE 9

Register of Deeds Stamp & File Number

For corners in Clinton (County)

	Located In:	Corner Code #
1. Public Land Survey	T 7N R 4W	K-12
	T ___ R ___	K-13
	T ___ R ___	
	T ___ R ___	
2. Property Controlling	S ___ T ___ R ___	
in Section	S ___ T ___ R ___	
3. Miscellaneous	S ___ T ___ R ___	
Property in Sec.	S ___ T ___ R ___	

4. Lot No. _____ , Recorded Plat _____
5. Private Claims _____

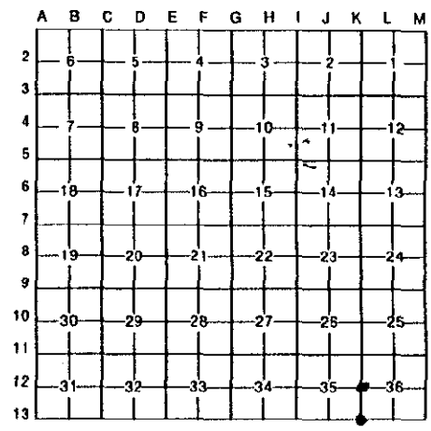

I, Arden S. Pierson P.S. a field survey on October 18, 1993, do hereby certify that under requirements of P.A. 74, Michigan P.A. of 1970, the corner points mentioned in lines 1 and 2 above were in conformance with regulations and rules therefore as required in the current manual of survey instructions of the United States Department of the Interior, Bureau of Land Management or by a decree of a Court of Law and/or that the corner points mentioned in lines 3, 4 and 5 above were in conformance with the rules of the Michigan Board of Land Surveyors or by a Decree of a Court of Law; established, re-established, monumented, re-monumented, recovered, found as expressed below:

NOTE: Not more than 4 corners, all in the same town and range, may be recorded *on this certificate.*

A. Description of original monument and accessories and/or subsequent restoration:

County Surveyor notes - Chas E. Hollister, Deputy Surveyor, March, 1894.

K-12 - Set stone for ¼ post (by division)

K-13 - Found stone set with brick around it

B. Description of corner evidence found and/or method applied in restoring or reestablishing corner:

Section 35, Dallas Township

K-12 (E ¼ corner) - Set Standard Clinton County Monument Midway on East Line of Section (1.8' East of center of pavement)

K-13 (SE corner) - Dug hole at location , did not find stone or brick Set Standard Clinton County Monument- at proportioned distance on Twp. line

C. Description of monument for corner and accessories established to perpetuate locating the position of the corner:

K-12 (E ¼ corner)
(Standard Clinton County Monument in Monument box)

N & T NE side 7" elm -N31°W- 60.25'
Power pole -N11°W- 119.69'
N & T S. side 7" elm -S82°E- 31.37'
NW corner large "MANKEY" tombstone base -S47°E- 121.11'

K-13 (SE corner)
(Standard Clinton County Monument in Monument box)

N & T NE side wood anchor post -N43°W- 42.30'
N & T NW side power pole -N80°E- 73.85'
N & T SW side service pole -S61°E- 100.60'
Face corner concrete project marker -S39°E- 37.34'

*Standard Clinton County Monument is a 2" steel tube , 30" long with a 3½" breakaway magnetic base and stamped brass cap.

Signed by Arden S. Pierson Date NOVEMBER 24, 1993

Surveyor's Michigan License No. 13039

APPROVED BY CLINTON COUNTY PEER GROUP
DATED 12/8/93
JTG

FORM APPROVED BY MICHIGAN STATE BOARD OF LAND SURVEYORS, JAN. 25, 1971
REVISED MAY 1, 1975
REVISED JAN. 1, 1983