

DUP

**NW CORNER OF SECTION 6, RILEY TWP.**

**LAND CORNER RECORDATION CERTIFICATE**  
**Filing Requirement of Act 74, Mich. P.A. 1970**

For corners in  
Clinton  
(County)

Located In: Corner Code #

LIBER 4, PAGE 54

RECORDED

DEC 12 12 01 PM '94

REGISTER OF DEEDS  
CLINTON COUNTY, MICH.

*Arden S. Pierson*

Register of Deeds Stamp & File Number

- 1. Public Land Survey T6N R3W A-1  
T7N R4W M-13
- 2. Property Controlling in Section S \_\_\_ T \_\_\_ R \_\_\_ \_\_\_
- 3. Miscellaneous Property in Sec. S \_\_\_ T \_\_\_ R \_\_\_ \_\_\_
- 4. Lot No. \_\_\_\_\_, Recorded Plat \_\_\_\_\_
- 5. Private Claims \_\_\_\_\_

A	B	C	D	E	F	G	H	I	J	K	L	M
2	6		5		4		3		2			
3												
4	7		8		9		10		11		12	
5												
6	18		17		16		15		14		13	
7												
8	19		20		21		22		23		24	
9												
10	30		29		28		27		26		25	
11												
12	31		32		33		34		35		36	
13												

Arden S. Pierson PS, in a field survey on March 10, 1994, do hereby certify that under requirements of P.A. 74, Michigan P.A. of 1970, the corner points mentioned in lines 1 and 2 above were in conformance with regulations and rules therefore as required in the current manual of survey instructions of the United States Department of the Interior, Bureau of Land Management or by a decree of a Court of Law and/or that the corner points mentioned in lines 3, 4 and 5 above were in conformance with the rules of the Michigan Board of Land Surveyors or by a Decree of a Court of Law; established, re-established, monumented, re-monumented, recovered, found as expressed below:

**NOTE: Not more than 4 corners, all in the same town and range, may be recorded on this certificate.**

**A. Description of original monument and accessories and/or subsequent restoration:**

A-1 - Original survey by Harvey Parke DS, 1826. Recorded in Liber 2, page 232, by Richard Steadman PS - "found large flat-topped stone 6" below road surface. Lowered stone to 1 ft. below surface and deposited 5 railroad spikes around it." With Witnesses:  
Wood anchor post -S88°E- 20.29'  
26" Hackberry -N76°W- 113.86'  
22" Apple -N18°E- 78.02'  
Telephone pole -S08°E- 155.54'

APPROVED BY  
CLINTON COUNTY PEER GROUP  
DATED 11/9/94  
*J.P.*

**B. Description of corner evidence found and/or method applied in restoring or reestablishing corner:**


**Section 6, Riley Township**

A-1 - Found 1/2" rod - 12" long, dug down and found stone with 5 RR spikes around it - Removed 12" long rod and drove 1/2" rod 24" long on South side and bent top of rod to point of stone. And accepted as a careful and faithful perpetuation of the position of the original corner. Removed 1/2" rod and RR spikes and Set Standard Clinton County Monument 8" below road surface. Placed stone on the North side of monument and deposited rod and RR spikes around the monument below the brass cap. (This corner is common to the following Townships, Westphalia, Dallas, Bengal and Riley.)

**C. Description of monument for corner and accessories established to perpetuate locating the position of the corner:**

**A-1 (NW corner Section 6)**  
**Clinton County Monument**

- PK nail & tag in S. side 32" Hackberry -N75°W- 114.15'
- Nail & tag #11370 N. side leaning wood fence post -S86°E- 20.42'
- North edge Stop sign post -S72°W- 34.16'
- NW corner telephone pedestal -N45°E- 46.37'

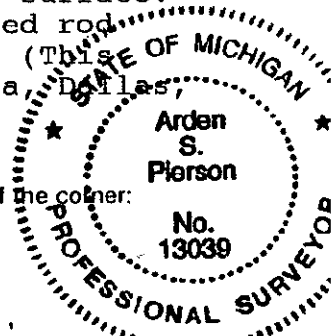

\*Standard Clinton County Monument is a 2 1/2" dia. steel tube 30" long with a stamped brass cap and breakaway magnetic base.

Signed by Arden S. Pierson

NOVEMBER 1, 1994

Date

Surveyor's Michigan License No. 13039