

**SURVEY & REMONUMENTATION**

**FEB 02 1998**

**REMONUMENTATION**

**SECTION 1, DUPLAIN TOWNSHIP**

**SECTION**

**LAND CORNER RECORDATION CERTIFICATE**

**Filing Requirement of Act 74, Mich. P.A. 1970**

**LIBER 004 PAGE 208**

For corners in	Located In:	Corner Code #
Clinton (County)		
1. Public Land Survey	T 8N R 1W	M-2
	T R	
	T R	
	T R	
2. Property Controlling in Section	S T R	
	S T R	
3. Miscellaneous Property in Sec.	S T R	
	S T R	

**RECORDED**

**Oct 17 9 18 AM '97**

REGISTER OF DEEDS  
CLINTON COUNTY, MICH.

*Wendy Papineau*

**Register of Deeds Stamp & File Number**

4. Lot No. \_\_\_\_\_, Recorded Plat \_\_\_\_\_  
5. Private Claims \_\_\_\_\_

I, Wendy A. Papineau, in a field survey on June 1997, do hereby certify that under requirements of P.A. 74, Michigan P.A. of 1970, the corner points mentioned in lines 1 and 2 above were in conformance with regulations and rules therefore as required in the current manual of survey instructions of the United States Department of the Interior, Bureau of Land Management or by a decree of a Court of Law and/or that the corner points mentioned in lines 3, 4 and 5 above were in conformance with the rules of the Michigan Board of Land Surveyors or by a Decree of a Court of Law; established, re-established, monumented, re-monumented, recovered, found as expressed below:

**NOTE: Not more than 2 corners, all in the same town and range, may be recorded on this certificate.**

**A. Description of original monument and accessories and/or subsequent restoration:**

**M-2 Standard East 1/4 Corner, Section 1, T8N-R1W**

Wood post placed by Robert Clark, Jr. D.S. Jan. 26, 1831  
S 49 W 21 lks (13.86') 14" White Oak  
N 47 W 27 lks (17.82') 11" Lynn

There are no records that indicate subsequent establishment or use of this position.

**B. Description of corner evidence found and/or method applied in restoring or reestablishing corner:**

**M-2 Standard East 1/4 Corner, Section 1, T8N-R1W**

Calculated a position on the Michigan Meridian, between Standard Section Corners of Section 1, at a midpoint (per G.L.O. notes). Measurements to the occupied 1/8 line (1324') fit well with the split (1324.59').

There appears to be no conflicting evidence and this position is accepted as the best available evidence of the position of the original government corner.

Approved by the joint Clinton/Shiawassee County Remonumentation Peer Review Group, August 13, 1997.


**C. Description of monument for corner and accessories established to perpetuate locating the position of the corner:**

**M-2 Standard East 1/4 Corner, Section 1, T8N-R1W**

Placed a Clinton County Monument, 2"x30" steel pipe, 3 1/4" brass cap and plastic base with a magnet

N50W 129.17' SE Cor. brick chimney  
S80E 27.42' PK w/tag T/C fnc post  
West 53.23' Set spike w/tag S. fc clump 6" Chinese Elm  
S20E 77.57' Fnd 3/4" pipe w/fnc line East

	A	B	C	D	E	F	G	H	I	J	K	L	M
1													
2	6	5	4	3	2	1							
3													
4	7	8	9	10	11	12							
5													
6	18	17	16	15	14	13							
7													
8	19	20	21	22	23	24							
9													
10	30	29	28	27	26	25							
11													
12	31	32	33	34	35	36							
13													

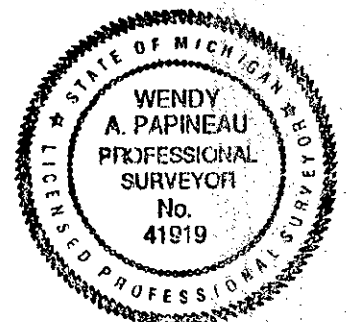

Signed by Wendy A. Papineau Date Oct. 8, 1997

Surveyor's Michigan License No. 41919

FORM APPROVED BY MICHIGAN STATE BOARD OF LAND SURVEYORS, JAN. 28, 1971  
REVISED MAY 14, 1975  
REVISED JAN., 1983  
ADAPTED FOR WORD PROCESSING MARCH, 1993

APPROVED BY  
CLINTON COUNTY PEER GROUP  
DATED 8/13/97  
J78