

SURVEY & REMONUMENTATION

FEB 02 1998

**REMONUMENTATION
SECTION 24, DUPLAIN TOWNSHIP**

SECTION

**LAND CORNER RECORDATION CERTIFICATE
Filing Requirement of Act 74, Mich. P.A. 1970**

LIBER 0014 PAGE 214

For corners in	Located In:	Corner Code #
Clinton (County)		
1. Public Land Survey	T 8N R 1W	M-8
	T R	
	T R	
	T R	
2. Property Controlling in Section	S T R	
	S T R	
3. Miscellaneous Property in Sec.	S T R	
	S T R	

RECORDED

OCT 17 9 18 AM '97

REGISTER OF DEEDS
CLINTON COUNTY, MICH.

Carrie Whiting

Register of Deeds Stamp & File Number

4. Lot No. _____, Recorded Plat _____
5. Private Claims _____

I, Wendy A. Papineau, in a field survey on June 1997

do hereby certify that under requirements of P.A. 74, Michigan P.A. of 1970, the corner points mentioned in lines 1 and 2 above were in conformance with regulations and rules therefore as required in the current manual of survey instructions of the United States Department of the Interior, Bureau of Land Management or by a decree of a Court of Law and/or that the corner points mentioned in lines 3, 4 and 5 above were in conformance with the rules of the Michigan Board of Land Surveyors or by a Decree of a Court of Law; established, re-established, monumented, re-monumented, recovered, found as expressed below:

NOTE: Not more than 2 corners, all in the same town and range, may be recorded on this certificate.

A. Description of original monument and accessories and/or subsequent restoration:

M-8 Standard East 1/4 Corner Section 24, T8N-R1W

Wood post placed by Robert Clark Jr., D.S. Jan. 26 1831
S 22 1/2 W 47 lks (31.02)' 6" Elm
N 68 W 40 lks (26.40)' 20" Black Ash

Unrecorded survey by James A. Porter, E.D.I., Oct. 9, 1986
Job No. 644-F (rev). No monument or references given

B. Description of corner evidence found and/or method applied in restoring or reestablishing corner:

M-8 Standard East 1/4 Corner Section 24, T8N-R1W

James Porter when running the East line of Sections 13,24,25,36, single proportioned (from M-13 to M-5), in searching for reliable positions for government corners. We found a 1/2" rod w/illegible cap in a monument box 3'E of centerline of Meridian Rd with tree occupation to the West.

There appears to be no conflicting evidence and this position is accepted as the best available evidence of the position of the original corner.

Approved by the joint Clinton/Shiawassee County Remonumentation Peer Review Group August 13, 1997.


C. Description of monument for corner and accessories established to perpetuate locating the position of the corner:

M-8 Standard East 1/4 Corner Section 24, T8N-R1W

Replaced 1/2" rod with a Clinton County Monument, 2"x30" steel pipe, 3 1/4" brass cap and plastic base with a magnet, in existing box.
West 3.0' Centerline Meridian Rd
S25E 105.91' Pk w/tag #39096 W. fc P/P
S85E 92.37' Set PK w/tag #39096 Top Wood Post
N50W 61.26' Set N&T #39096 SW fc 8" Box Elder
West 75.52' End N&T #19003 N. fc 18" Elm

	A	B	C	D	E	F	G	H	I	J	K	L	M
1													
2	6	5	4	3	2	1							
3													
4	7	8	9	10	11	12							
5													
6	18	17	16	15	14	13							
7													
8	19	20	21	22	23	24							
9													
10	30	29	28	27	26	25							
11													
12	31	32	33	34	35	36							
13													

Signed by Wendy A. Papineau Date Oct 8, 1997
Surveyor's Michigan License No. 41919

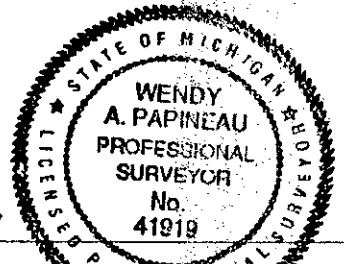

FORM APPROVED BY MICHIGAN STATE BOARD OF LAND SURVEYORS, JAN. 28, 1971
REVISED MAY 14, 1976
REVISED JAN., 1983
ADAPTED FOR WORD PROCESSING MARCH, 1983

APPROVED BY
CLINTON COUNTY PEER GROUP
DATED 8/13/97
J 709