

**SURVEY &
REMONUMENTATION**

FEB 18 1999

APPROVED BY
CLINTON COUNTY PEER GROUP
DATED 9/24/97
g 49

**SECTION REMONUMENTATION
GREENBUSH TOWNSHIP**

LIBER 004 PAGE 321

LAND CORNER RECORDATION CERTIFICATE


Filing Requirement of Act 74, Mich. P.A. 1970

RECORDED

For corners in

Clinton (County) Located In: Corner Code #

- 1. Public Land Survey T 8N R 2W L-13
 T R
 T R
 T R
- 2. Property Controlling S T R
 In Section S T R
- 3. Miscellaneous S T R
 Property in Sec. S T R
- 4. Lot No. _____ Recorded Plat _____
- 5. Private Claims _____

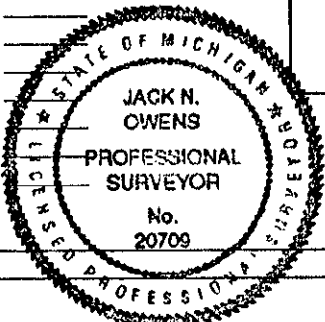

JAN 7 11 01 AM '99

REGISTER OF DEEDS
CLINTON COUNTY, MICH.

Carol Whaley

Register of Deeds Stamp & File Number

	A	B	C	D	E	F	G	H	I	J	K	L	M
1													
2	6	5	4	3	2	1							
3													
4	7	8	9	10	11	12							
5													
6	18	17	16	15	14	13							
7													
8	19	20	21	22	23	24							
9													
10	30	29	28	27	26	25							
11													
12	31	32	33	34	35	36							
13													

I, Jack N. Owens, P.S., in a field survey on AUGUST 27 19 97, do hereby certify that under requirements of P.A. 74, Michigan P.A. of 1970, the corner points mentioned in lines 1 and 2 above were in conformance with regulations and rules therefore as required in the current manual of survey instructions of the United States Department of the Interior, Bureau of Land Management or by a decree of a Court of Law and/or that the corner points mentioned in lines 3, 4 and 5 above were in conformance with the rules of the Michigan Board of Land Surveyors or by a Decree of a Court of Law; established, re-established, monumented, re-monumented, recovered, found as expressed below:

NOTE: Not more than 4 corners, all in the same town and range, may be recorded on this certificate.

A. Description of original monument and accessories and/or subsequent restoration:

L-13 STANDARD 1/4 CORNER, S. LINE, T8N, R2W
 GLO - ORIGINAL SURVEY BY ROBERT CLARK, JR., D.S., 1831.
 WOOD POST SET ON S. LINE TWP. AT 40.00 CHS FROM CORNERS M-13 7 K-13.
 ACCESSORIES: N49°W 12 LKS (7.9') 16" BEECH & N52-1/2°E 21 LKS (13.9') 6" BEECH.

 UNRECORDED SURVEY FOR THOMPSON-McCULLY; LARRY A. BRYAN, PS 25832; ACT 132 CERTIFIED SURVEY, 6/18/1996.
 JOB 97-B-54212; SURVEY OF SW 1/4, SEC. 36, T8N, R2W, GREENBUSH TWP. SET BAR/CAP #25832 AT BASE OF 12" WOOD ANCHOR POST, FNC - N, E & W.
 ACCESSORIES: FND: S77°E 31.77' N/TAG #3829 N. FC 40" MAPLE.
SET: SOUTH 10.87' N/TAG #25832 E FC 5" MAPLE, NORTH 19.50' N/TAG #25832 E FC 21" MAPLE & BRG? DIST? PK NAIL N FC 6" ELM; N89°23'33"W 2648.07' SW COR SEC 36 T8N, R2W.

B. Description of corner evidence found and/or method applied in restoring or reestablishing corner:

RETRACED TWP. LINE BTWN. T8N & T7N, R2W FROM COR. M-13 TO L-13 TO K-13 AND RECOVERED MONUMENTATION FROM SURVEY NOTED IN PART A. DISTANCE MATCH GLO AND BRYAN SURVEY. AT COR. L-13 RECOVERED 1/2" REBAR/CAP #25832 SET BY P.S. BRYAN. A NEW FNC HAD JUST BEEN BUILT ALONG SIDES OF SW 1/4. USING ACCESSORIES I CONCLUDED THAT THE FENCE COMPANY HAD REMOVED THE REBAR AND TRIED TO REPLACE IT IN SAME LOCATION BUT IT WAS 0.6' TOO FAR EAST. RESET IT CORRECTLY FROM BRYAN ACCESSORIES AND DISTANCES. FROM COR. K-13 TO L-13 MEASURED 2648.12' (40.123 CHS), VIRTUALLY IDENTICAL TO BRYAN RECORD DISTANCE OF 2648.07'.

P.S. BRYAN RE-ESTABLISHED THE CORNER FROM THE COLLATERAL EVIDENCE OF THE FENCE & THE REASONABLE MATCH TO THE GLO RECORD. I CONCLUDE AND ACCEPT THAT THE 1/2" REBAR/CAP FOUND AT THE POSITION FOR COR. L-13 IS THE BEST AVAILABLE EVIDENCE OF THE POSITION OF THE ORIGINAL CORNER.

C. Description of monument for corner and accessories established to perpetuate locating the position of the corner:

COR. L-13 REPLACE THE 1/2" REBAR WITH BERNTSEN MONUMENT Accessories: N10W 0.61' SE FC STEEL FNC POST
 SS-A-5-BR-30 (3-1/4" D. BRASS CAP STAMPED SOUTH 10.87' FND N/TAG 25832 E FC 5" MAPLE
 "CLINTON COUNTY REMONUMENTATION CORNER, NORTH 19.50' FND N/TAG 25832 E FC 21" MAPLE
L-13, T8NR2W PS 20709," WITH 30" X 2-3/8" O.D. S55W 37.51' FND PK NAIL N FC 6" ELM
 STAINLESS STEEL TUBE) AT 0. GRADE. S55E 31.01' FND N/TAG 25832 N FC 40" MAPLE
 S89°49'38"E 2651.57' M-13 (REMON COR. L.4,P.239) EAST 37.40' FND 3/4" PINCHED PIPE
 N89°28'51"W 2648.12' K-13 (REMON COR.)

Signed by *Jack N. Owens* Date SEPTEMBER 23, 1998
 Surveyor's Michigan License No. 20709