

SURVEY & REMONUMENTATION

APR 27 1995 E 1/4 CORNER OF SECTION 21, ESSEX TWP.

COMMISSION

LAND CORNER RECORDATION CERTIFICATE
Filing Requirement of Act 74, Mich. P.A. 1970

For corners in
Clinton
(County)

Located In: Corner Code: #/

- | | | |
|---------------------------------------|-------------------------|-------|
| 1. Public Land Survey | T <u>8N</u> R <u>3W</u> | G-8 |
| | T _____ R _____ | _____ |
| | T _____ R _____ | _____ |
| | T _____ R _____ | _____ |
| 2. Property Controlling
in Section | S _____ T _____ R _____ | _____ |
| | S _____ T _____ R _____ | _____ |
| 3. Miscellaneous
Property in Sec. | S _____ T _____ R _____ | _____ |
| | S _____ T _____ R _____ | _____ |

4. Lot No. _____, Recorded Plat _____
5. Private Claims _____

RECORDED

LIBER 4, PAGE 61

Dec 12 12 01 PM '94

REGISTER OF DEEDS
CLINTON COUNTY, MICH.
Law's Work

Register of Deeds Stamp & File Number

	A	B	C	D	E	F	G	H	I	J	K
2	6		5		4		3		2		
3											
4	7		8		9		10		11		
5											
6	18		17		16		15		14		
7											
8	19		20		21	●	22		23		
9											
10	30		29		28		27		26		
11											
12	31		32		33		34		35		
13											

Arden S. Pierson PS, in a field survey on March 14, 19 94, do hereby certify that under requirements of P.A. 74, Michigan P.A. of 1970, the corner points mentioned in lines 1 and 2 above were in conformance with regulations and rules therefore as required in the current manual of survey instructions of the United States Department of the Interior, Bureau of Land Management or by a decree of a Court of Law and/or that the corner points mentioned in lines 3, 4 and 5 above were in conformance with the rules of the Michigan Board of Land Surveyors or by a Decree of a Court of Law; established, re-established, monumented, re-monumented, recovered, found as expressed below:

NOTE: Not more than 4 corners, all in the same town and range, may be recorded on this certificate.

A. Description of original monument and accessories and/or subsequent restoration:
 G-8 - Original survey by Joel Wright DS, 1831.
 County Surveyor records show in a survey by Chas E. Hollister, County Surveyor, dated November, 1889, that he found a stone as the quarter post. With Witnesses:
 13" White Oak -S65½°E- 86 3/4 links (57.26')*
 2" Red Oak -S44½°W- 73 links


***(SEE BACK OF SHEET)**

B. Description of corner evidence found and/or method applied in restoring or reestablishing corner:

Section 21, Essex Township

G-8 - Found stone as called for in County Surveyor Notes recorded by Chas E. Hollister dated November 5, 1889. Accepted stone as a careful and faithful perpetuation of the position of the original corner. Placed Standard Clinton County Monument and placed stone on South side of monument.

APPROVED BY
CLINTON COUNTY PEER GROUP
DATED 12/7/94
J. P. [Signature]

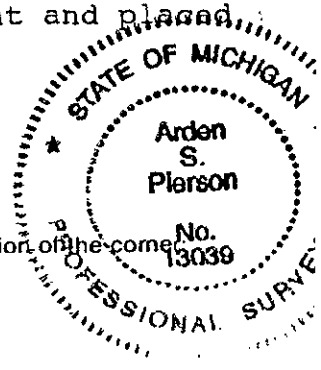

C. Description of monument for corner and accessories established to perpetuate locating the position of the corner:
G-8 (E 1/4 corner Section 21)
Clinton County Monument

- Nail & tag #13039 N. side 42" Oak -S65°E- 57.57' *(B.T.)
- Nail & tag #13039 N. side 35" Oak -S73°E- 88.52'
- Nail & tag #13039 S. side 12" Oak -S68°W- 29.44'
- SW corner underground petroleum sign -S40°E- 50.19'
- NW corner telephone pedestal -S43°E- 51.47'

*Standard Clinton County Monument is a 2½" steel tube 30" long with a stamped brass cap and a breakaway magnetic base.

Signed by Arden S. Pierson Date November 1, 1994

Surveyor's Michigan License No. 13039

E 1/4 CORNER OF SECTION 21, ESSEX TOWNSHIP

LCRC - Liber 2, page 930, by Arden S. Pierson, PS #13039, dated July 28, 1989. Records 1/2" iron @ large pointed stone

Witnesses:

42" Oak -S65°E- 57.55'
36" Oak -S73°E- 88.47'
.8" Oak -S68°W- 29.28'

LCRC - Liber 2, page 776, by Mark VanRaemdonck, PS #24622, dated June 28, 1990. Records rerod and cap #13039

Witnesses:

S70°E- 57.54' Fnd Nail & tag #13039 in N. face 48" Oak
S80°E- 88.48' Fnd Nail & tag #13039 in N. face 48" Oak
S65°W- 29.51' Fnd Nail & tag #13039 in S. face 8" Oak
N45°W- 18.55' W. edge road sign post

LIBER 4, PAGE 62