


LAND CORNER RECORDATION CERTIFICATE
Filing Requirement of Act 74, Mich. P.A. 1970

For corners in CRAWFORD
 (County)

Located In:

Corner Code #

- | | | |
|------------------------------------|-------------------------|-------------|
| 1. Public Land Survey | T <u>25</u> R <u>1W</u> | <u>B-13</u> |
| | T _____ R _____ | _____ |
| | T _____ R _____ | _____ |
| | T _____ R _____ | _____ |
| 2. Property Controlling in Section | S _____ T _____ R _____ | _____ |
| | S _____ T _____ R _____ | _____ |
| 3. Miscellaneous | S _____ T _____ R _____ | _____ |
| Property in Section | S _____ T _____ R _____ | _____ |

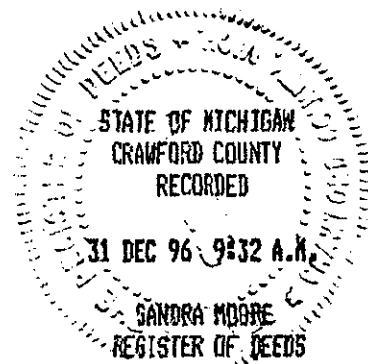

Register of Deeds Stamp & File Number

4. Lot No. _____, Recorded Plat _____
5. Private Claims _____

LIBER 3 PAGE 255

A	B	C	D	E	F	G	H	I	J	K	L	M
2	6	5	4	3	2	1						
3												
4	7	8	9	10	11	12						
5												
6	18	17	16	15	14	13						
7												
8	19	20	21	22	23	24						
9												
10	30	29	28	27	26	25						
11												
12	31	32	33	34	35	36						
13												

I, Marvin E. Myers, P.S. in a field survey on Nov 21, _____, 19 96, do hereby certify that under requirements of P.A. 74, Michigan P.A. of 1970, the corner points mentioned in lines 1 and 2 above were in conformance with regulations and rules therefore as required in the current manual of survey instructions of the United States Department of the Interior, Bureau of Land Management or by a decree of a Court of Law and/or that the corner points mentioned in lines 3, 4 and 5 above were in conformance with the rules of the Michigan Board of Professional Surveyors or by a Decree of a Court of Law; established, re-established, monumented, re-monumented, recovered, found as expressed below:

NOTE: Not more than 4 corners, all in the same town and range, may be recorded on this certificate.

A. Description of original monument and accessories and/or subsequent restoration:

- | | |
|---|---|
| GLO-May 1839 J. Brink
Mon-Post
Wit-8" Aspen N24½E 37 Lks
10" Aspen N7°W 38 Lks | L. 2, P. 437
Mon- Pav't box

L.365, P.322 F.J. Arleth
Mon-Pav't box 0.4 Below Pav't |
| USGLO G. Veal 1937
Mon- Intersection of Roads and fence line North accepted as best available evidence of the position of the Original corner.
Set 10" long by 6" Dia. Concrete block.
Wit-Set witness monument N50°E 70 Lks | |

B. Description of corner evidence found and/or method applied in restoring or reestablishing corner:

Found 1"x46" Iron bar in Pav't Box 4" below asphalt at intersection of road centerline and fence line North.
 Found witness spike in fence post North 33.5
 Accepted as the best available evidence of the position of the Original Corner.



C. Description of monument for corner and accessories established to perpetuate locating the position of the corner:

Replace 1" Iron bar with standard Roscommon Co. Monument in monument box.
 Wit: Nail & tag in Telephone Pole N61°E 167.44
 Nail & tag in Telephone pole N36°W 126.83
 Nail & tag in 8" B. Oak S46°E 78.89
 Nail & tag in 4" W. Pine S45°W 53.43

CRAWFORD COUNTY
PEER GROUP APPROVAL
 DATE NOV 22, 1996

Marvin E. Myers
Marvin E. Myers, P.S.
 County Surveyor

Signed by *Marvin E. Myers* Date Dec 13, 1996

Surveyor's Michigan License No. 31600