


LAND CORNER RECORDATION CERTIFICATE
Filing Requirement of Act 74, Mich. P.A. 1970

For corners in CRAWFORD
 (County)

Located In:

Corner Code #

- | | | | | | |
|--------------------------------------|---|-----------|---|-----------|-------------|
| 1. Public Land Survey | T | <u>25</u> | R | <u>1W</u> | <u>C-13</u> |
| | T | | R | | |
| | T | | R | | |
| | T | | R | | |
| 2. Property Controlling in Section | S | | T | R | |
| | S | | T | R | |
| 3. Miscellaneous Property in Section | S | | T | R | |
| | S | | T | R | |

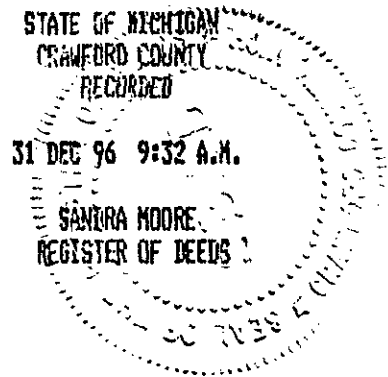

Register of Deeds Stamp & File Number

4. Lot No. _____, Recorded Plat _____
 5. Private Claims _____

LIBER 3 PAGE 256

I, Marvin E. Myers, in a field survey on November, 1996, do hereby certify that under requirements of P.A. 74, Michigan P.A. of 1970, the corner points mentioned in lines 1 and 2 above were in conformance with regulations and rules therefore as required in the current manual of survey instructions of the United States Department of the Interior, Bureau of Land Management or by a decree of a Court of Law and/or that the corner points mentioned in lines 3, 4 and 5 above were in conformance with the rules of the Michigan Board of Professional Surveyors or by a Decree of a Court of Law; established, re-established, monumented, re-monumented, recovered, found as expressed below:

	A	B	C	D	E	F	G	H	I	J	K	L	M
2	6	5	4	3	2								
3													
4	7	8	9	10	11	12							
5													
6	18	17	16	15	14	13							
7													
8	19	20	21	22	23	24							
9													
10	30	29	28	27	26	25							
11													
12	31	32	33	34	35	36							
13													

NOTE: Not more than 4 corners, all in the same town and range, may be recorded on this certificate.

A. Description of original monument and accessories and/or subsequent restoration:

GLO-May 1839 John Brink
 Mon.-Post
 WIT: 8" Synn N50°E 33 lks.
 8" Synn N40°W 22 lks.

R.T. Ostling May 22, 1956
 Mon.-MSHD mon. box
 WIT: 8' N of C W road
 ½" bar S 41'

F.J. Arleth
 L.365, pg.323
 Mon.-Pav't box
 WIT: None given

GLO June 1852 William Burt
 WIT: 6" Synn S45°E 9 lks.
 8" Synn S50°W 38 lks.

Feldhauser July 7, 1970
 Mon.-Mon. Box
 WIT: Iron set South 33.0'

L.2, pg.436
 Mon.-Pav't box

US GLO G. Veal 1937
 Mon.-Accepted intersection of roads as the best available evidence of the position of the original corner. Set 10" long by 6" dia. concrete to mark corner
 WIT: Set a 6" dia. x 24" long concrete witness monument with 3½" Brass Tablet N45°W 71 lks.

G.D. Henning Aug. 24, 1973
 L.279, pg.544
 Mon.-Pav't box in section corner 8' N of C road
 WIT: Set by Highway Dept. from US Survey in 1937

L.2, pg.437
 Mon.-Pav't box

G.D. Henning Nov. 9, 1948
 Mon.-
 WIT: Set pipe 33' South of corner

F.J. Arleth May 2, 1975
 L.145, pg.172 (Crawford County)
 Mon.-Fd. ½" in pav't box
 G.D. Henning Aug. 26, 1983
 L.436, pg.327
 Mon.-Not given
 WIT: 1.34' S of C of M-18

B. Description of corner evidence found and/or method applied in restoring or reestablishing corner:


Found monument box found 1" Iron Bar inside
 Found 1" iron bar
 Found ½" Bar 33.0' South
 1.3' South of East - West centerline
 7' East of centerline road North on fence line South
 This position is accepted as the best available evidence of the position of the Original Corner.

C. Description of monument for corner and accessories established to perpetuate locating the position of the corner:

Replaced ½" bar with Standard Crawford County Monument in monument box.
 WIT: Flooter Rd. sign post N24°E 54.92'
 P.P. East face N14°W 98.72'
 P.P. West face S06°E 38.38'
 ½" Iron Bar S03°W 33.06'

CRAWFORD COUNTY
PEER GROUP APPROVAL
 DATE NOV 22, 1996

Marvin E. Myers
Marvin E. Myers, P.S.
 County Surveyor

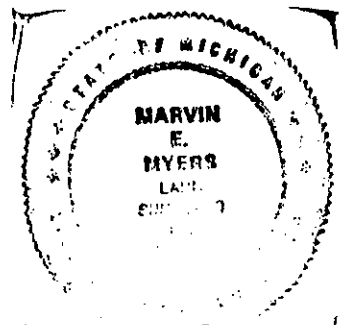

Signed by *Marvin E. Myers*
 Surveyor's Michigan License No. 31600

Date December 13, 1996