


**LAND CORNER RECORDATION CERTIFICATE**  
**Filing Requirement of Act 74, Mich. P.A. 1970**

|  |                          |               |
|--|--------------------------|---------------|
| For corners in<br><u>Crawford</u><br><small>(County)</small> | Located In:              | Corner Code # |
| 1. Public Land Survey  | T <u>25N</u> R <u>1W</u> | <u>E 13</u>   |
|  | T _____ R _____          | _____         |
|  | T _____ R _____          | _____         |
|  | T _____ R _____          | _____         |
| 2. Property Controlling<br>In Section                        | S _____ T _____ R _____  | _____         |
|  | S _____ T _____ R _____  | _____         |
| 3. Miscellaneous<br>Property in Section                      | S _____ T _____ R _____  | _____         |
|  | S _____ T _____ R _____  | _____         |

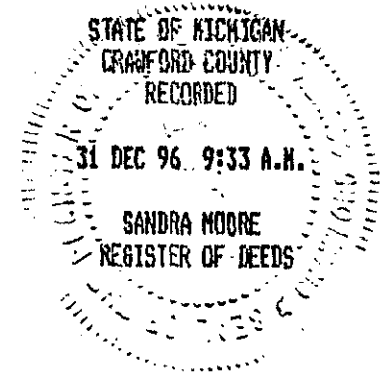

Register of Deeds Stamp & File Number

4. Lot No. \_\_\_\_\_, Recorded Plat \_\_\_\_\_  
 5. Private Claims \_\_\_\_\_

**LIBER 3 PAGE 258**

| A  | B  | C  | D  | E  | F  | G  | H | I | J | K | L | M |
|----|----|----|----|----|----|----|---|---|---|---|---|---|
| 2  | 6  | 5  | 4  | 3  | 2  | 1  |   |   |   |   |   |   |
| 3  |    |    |    |    |    |    |   |   |   |   |   |   |
| 4  | 7  | 8  | 9  | 10 | 11 | 12 |   |   |   |   |   |   |
| 5  |    |    |    |    |    |    |   |   |   |   |   |   |
| 6  | 18 | 17 | 16 | 15 | 14 | 13 |   |   |   |   |   |   |
| 7  |    |    |    |    |    |    |   |   |   |   |   |   |
| 8  | 19 | 20 | 21 | 22 | 23 | 24 |   |   |   |   |   |   |
| 9  |    |    |    |    |    |    |   |   |   |   |   |   |
| 10 | 30 | 29 | 28 | 27 | 26 | 25 |   |   |   |   |   |   |
| 11 |    |    |    |    |    |    |   |   |   |   |   |   |
| 12 | 31 | 32 | 33 | 34 | 35 | 36 |   |   |   |   |   |   |
| 13 |    |    |    |    |    |    |   |   |   |   |   |   |

I, Marvin E. Myers, in a field survey on November, 1996, do hereby certify that under requirements of P.A. 74, Michigan P.A. of 1970, the corner points mentioned in lines 1 and 2 above were in conformance with regulations and rules therefore as required in the current manual of survey instructions of the United States Department of the Interior, Bureau of Land Management or by a decree of a Court of Law and/or that the corner points mentioned in lines 3, 4 and 5 above were in conformance with the rules of the Michigan Board of Professional Surveyors or by a Decree of a Court of Law; established, re-established, monumented, re-monumented, recovered, found as expressed below:

**NOTE: Not more than 4 corners, all in the same town and range, may be recorded on this certificate.**

**A. Description of original monument and accessories and/or subsequent restoration:**

|   |   |   |
|---|---|---|
| GLO-John Brink May 1839<br>Mon.-Post<br>WIT: 6" Pitch Pine N55°E 42 lks.                          | US GLO Guy Veal 1937<br>Mon.-Intersection of Road is accepted as a perpetuation of the original corner position. Set a block of concrete 8" long 6" in Dia. 18" in the ground to mark corner<br>WIT: Wit. Mon. N45°E 71 lks. 6" dia. x 24" with 3 1/2" dia. Brass Tablet from which the following witnesses were taken:<br>5" J.Pine N23 3/4°E 20 lks.<br>6" J.Pine N18 1/2°W 16 lks. | G.D. Henning July 1, 1975<br>L.171, pg.519 (Crawford County)<br>Mon.-None given<br>WIT: None given                                |
| GLO William Burt June 1852<br>WIT: 8" Y.Pine S80 1/2°E 13 lks. Old Bearing 6" Aspen S50°W 39 lks. | HERNING 1942<br>PLAT OF SILVER WOODS<br>L.3, pg. 30 (Crawford County Records)<br>Sept. 1971   | F.J. Arleth July 25, 1975<br>Mon.-1/2" bar<br>WIT: 16" B.Oak N31°W 110.3'<br>14" B.Oak N48°E 73.7'                                |
|   |   | G.D. Henning July 25, 1975<br>L.148, pg.161 (Crawford County)<br>Mon.-None given<br>WIT: None given                               |
|   |   | L.2, pg.436<br>Mon.-1/2" Bar in place GLO Mon.<br>WIT: Mon. N45°E 46.9' wit. mon. 16" B.Oak N31°W 110.3'<br>14" B.Oak N48°E 73.7' |

**B. Description of corner evidence found and/or method applied in restoring or reestablishing corner:**


Found 1/2" bar in water valve box  
 Found 16" B. Oak N31°W 110.3'  
 Found 14" B.Oak N48°E 73.7'  
 Found 1/2" Bar N39°W 48.47'  
 Accepted as the best available evidence of the position of the Original corner.

**C. Description of monument for corner and accessories established to perpetuate locating the position of the corner:**

Replaced 1/2" bar with Mon. Box & standard Roscommon County Monument  
 WIT: 6" W.Pine N60°E 55.14'  
 6" Spruce N39°W 67.43'  
 Stop Sign Post North post S77°W 69.81'  
 6" J.Pine S31°E 58.80'  
 1/2" Bar N39°W 48.47'

**CRAWFORD COUNTY**  
**PEER GROUP APPROVAL**  
 DATE NOV 22, 1996

*Marvin E. Myers*  
**Marvin E. Myers, P.S.**  
 County Surveyor

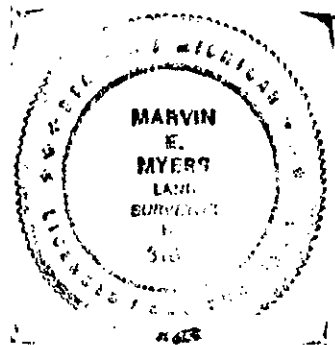

Signed by Marvin E. Myers Date December 13, 1996

Surveyor's Michigan License No. 31600