

MAR 29 2000

SECTION

LAND CORNER RECORDATION CERTIFICATE
Filing Requirement of Act 74, Mich P.A. 1970

For corners in
Crawford County

LIBER

4 PAGE 46

Located in: Corner Code #

1. Public Land Survey

T25N	R1W	H-13
T	R	
T	R	
T	R	

STATE OF MICHIGAN
COUNTY OF CRAWFORD

FILED FOR RECORD THIS
29th DAY OF Sept, 1999 AT
9:00 (am/pm), IN LIBER 4
PAGE 46

Sandra Moore

Register of Deeds

Register of Deeds Stamp & File Number

I, Larry L. Cavanagh, in a field survey May 1999, do hereby certify that under requirements of P.A. 74, Michigan P.A. of 1970, the corner points mentioned in line 1 above was in conformance with regulations and rules therefore as required in the current manual of survey instructions of the United States Department of the Interior, Bureau of Land Management or by a decree of a Court of Law; established, re-established, monumented, recovered, found as expressed below:

A. Description of original monument and accessories and/or subsequent restoration:

JOHN BRINK 1839 SET POST YELLOW PINE 9° N32 1/2°E 1.01 CHNS YELLOW PINE 8° N12°W 35 LKS	T.N. CANADA 1937 FD REMAINS OF ORIGINAL B TREES SET CONC MON 6" DIA X 24"/BRASS CAP & STEM NORWAY PINE ST. 10° N12 1/2°W 35 LKS NORWAY PINE ST. 10° N34 1/4°E 101 LKS (LOCAL BEARING TREES) NORWAY PINE 3° N34°E 80 LKS J. PINE 6° N48 3/4°W 70 LKS (NEW BEARING TREES) NORWAY PINE 10° N30 1/2°E 140 LKS NORWAY PINE 9° NORTH 149 LKS
LCRC 1970'S L2, P434 CONC MON N34°E 52.8 3" NORWAY N49°W 46.2 6" J. PINE N30°E 92.4' 10" NORWAY NORTH 98.3' 9" NORWAY	FRANK ARLETH, RLS 1988 NO MONUMENT MATERIAL CALLED OUT 8" J. PINE STP N48°W 46.2' 12" N. PINE N28°E 92.4' 10" N. PINE NORTH 98.3'

	A	B	C	D	E	F	G	H	I	J	K	L	M
2	6		5		4		3		2		1		
3													
4	7		8		9		10		11		12		
5													
6	18		17		16		15		14		13		
7													
8	19		20		21		22		23		24		
9													
10	30		29		28		27		26		25		
11													
12	31		32		33		34		35		36		
13													

B. Description of corner evidence found and/or method applied in restoring or reestablishing corner:

FOUND GLO MONUMENT /BRASS CAP
NORWAY PINE 3° N34°E 52.8'
J. PINE 6° N49°W 46.2'
NORWAY PINE 10° N30°E 92.4'
NORWAY PINE 9° NORTH 93.3'


A PERPETUATION OF THE ORIGINAL GOVERNMENT CORNER.

C. Description of monument for corner and accessories established to perpetuate locating the position of the corner:

LEFT US-GLO MONUMENT IN PLACE
WIT: NAIL & TAG IN 4" W. PINE N43°W (NEW) 25.23'
NAIL & TAG IN 5" MAPLE S37°E (NEW) 39.08'
NAIL & TAG IN 9" MAPLE S31°W (NEW) 33.20'
NAIL & TAG IN 12" N. PINE N34°E 52.95' (OLD)
CARSONITE POST SOUTH 26.72'

CRAWFORD COUNTY
PEER GROUP APPROVAL
DATE Sept 10, 1999

Marvin E. Myers MEM
Marvin E. Myers, P.S.
County Surveyor

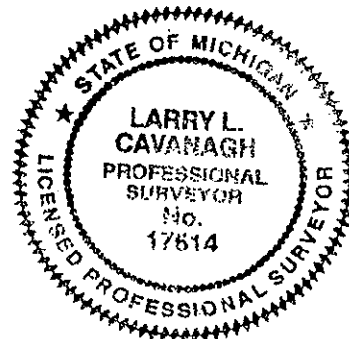

Signed by *Larry L. Cavanagh* Date Sept. 14, 1999
Surveyor's Michigan License NO. 17614