


STATE OF MICHIGAN
DEPARTMENT
OF
NATURAL RESOURCES

LAND CORNER RECORD

CRAWFORD COUNTY
T 25 N R 1 W

DESCRIPTION OF CORNER Center 1/4 corner
CORNER MONUMENT Set 1"x24" pipe
DATE MONUMENT PLACED AND WITNESSED 9-2-71
WITNESSES TO CORNER.....

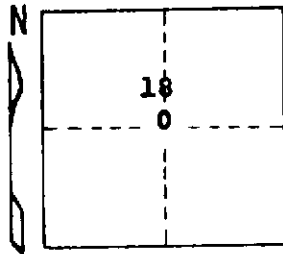


6" Balsam N 62 W 19.1'
4" Balsam N 20 E 17.7'
AND

CIRCLE CORNER REGISTERED

DESCRIPTION IN DETAIL AS TO HOW CORNER WAS LOCATED AND IDENTIFIED OR RESTORED.

Corner set at intersection of true 1/4 lines.

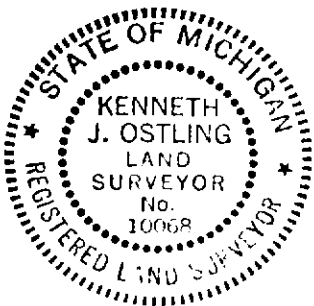

SURVEYOR'S SEAL

SIGNED Kenneth J. Ostling DATE 11/16/71
REGISTERED LAND SURVEYOR 10068

DISTRIBUTION:

County Courthouse
Area Forester (Regions I & II)
District or Region Surveyor
Forestry Div., Lansing

R 4047
Rev. 10/68