


ENTIRE TWP, RESURVEYED + MONUMENTED, about 1932  
 CONC. MON. / BRASS CAPS by S. L. M.

Form 974.

T. 25 N. R. 1 W. Mer.

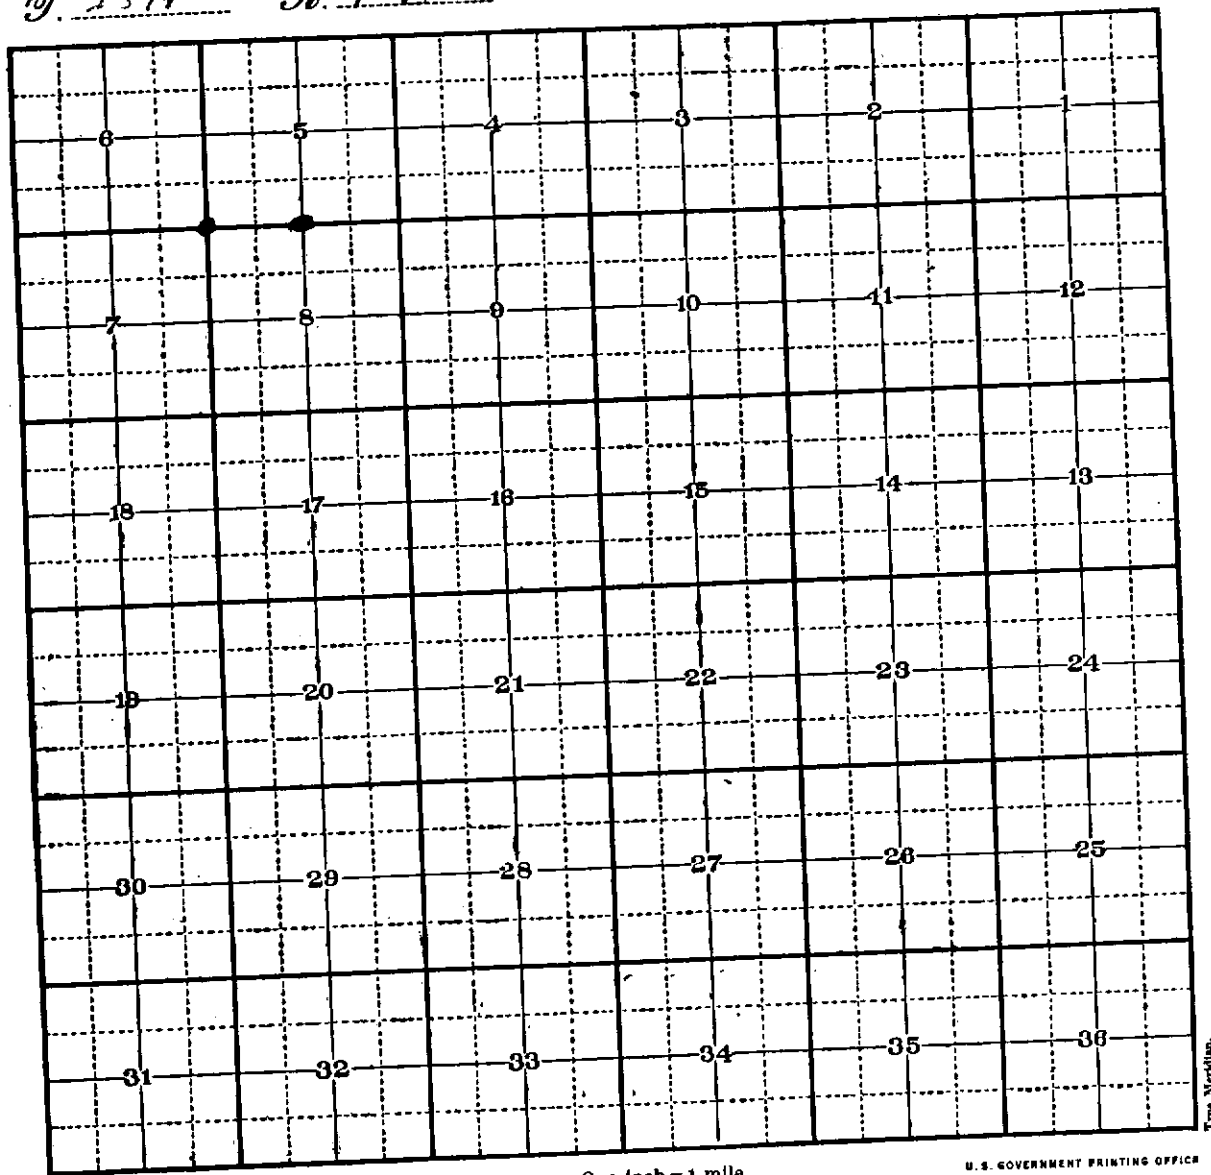

SCALE - One inch = 1 mile.

U. S. GOVERNMENT PRINTING OFFICE

True Meridian.