

**SURVEY & REMONUMENTATION**

APR 07 1998

SECTION

**LAND CORNER RECORDATION CERTIFICATE**  
Filing Requirement of Act 74, Mich P.A. 1970

For corners in  
Crawford County

**LIBER**

**3 PAGE 280**

STATE OF MICHIGAN  
COUNTY OF CRAWFORD

FILED FOR RECORD THIS  
20 DAY OF Nov, 1997 AT  
9:30 am/pm, IN LIBER 3 OF LC  
PAGE 280

*Sandra Moore*

Register of Deeds

Register of Deeds Stamp & File Number

1. Public Land Survey

Located in:	Corner Code #
T26N R 3W	M-13
T25N R 3W	M-1
<u>T25N R 2W</u>	<u>A-1</u>
T26N R 2W	A-13

I, Larry L. Cavanagh, in a field survey September, 1997, do hereby certify that under requirements of P.A. 74, Michigan P.A. of 1970, the corner points mentioned in line 1 above was in conformance with regulations and rules therefore as required in the current manual of survey instructions of the United States Department of the Interior, Bureau of Land Management or by a decree of a Court of Law; established, re-established, monumented, recovered, found as expressed below:

A. Description of original monument and accessories and/or subsequent restoration:

SET ADDISON P. BREWER  
SET POST  
PINE 10 N30 1/2W 11  
PINE 8 S48W 15

KENNETH J. OSTLING 10068 1979  
FD 1/2" IRON BAR AT CORNER  
BY HENNING, 1937  
NO WITNESSES

*[Signature]*

A	B	C	D	E	F	G	H	I	J	K	L	M
2	6	5	4	3	2	1						
3												
4	7	8	9	10	11	12						
5												
6	18	17	16	15	14	13						
7												
8	19	20	21	22	23	24						
9												
10	30	29	28	27	26	25						
11												
12	31	32	33	34	35	36						
13												

B. Description of corner evidence found and/or method applied in restoring or reestablishing corner:

FD 1/4" BAR AND THE REMAINS OF AN OLD WOOD POST


C. Description of monument for corner and accessories established to perpetuate locating the position of the corner:

SET CRAWFORD COUNTY MONUMENT STAMPED 17614 1997  
NAIL & TAG IN 7" J. PINE N29°W 66.93'  
NAIL & TAG IN 9" J. PINE N26°E 30.15'  
NAIL & TAG IN 8" J. PINE S13°E 41.03'  
NAIL & TAG IN 9" J. PINE S55°W 32.16'  
CARSONITE POST S12°W 21.10'

THE BEST AVAILABLE EVIDENCE OF THE POSITION OF THE ORIGINAL CORNER.

**CRAWFORD COUNTY**  
**PEER GROUP APPROVAL**  
DATE OCT 16, 1997

*Marvin E. Myers*  
Marvin E. Myers, P.S.  
County Surveyor

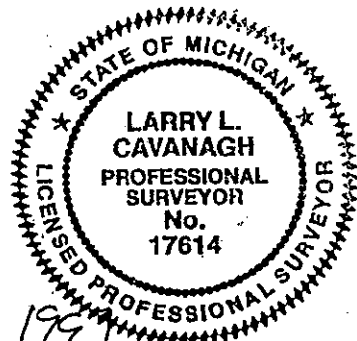

Signed by *Larry L. Cavanagh*  
Surveyor's Michigan License NO. 17614

Date Oct 22, 1997