

SURVEY & REMONUMENTATION

APR 27 1995

COMMISSION

CRAWFORD COUNTY
PEER GROUP APPROVAL
DATE DEC 29 1994

LIBER 3 PAGE 162

LAND CORNER RECORDATION CERTIFICATE
Filing Requirement of Act 74, Mich. P.A. 1970

For corners in

Crawford

(County)

Located In:

Corner Code ##

- | | | | | | |
|---------------------------------------|---|------------|---|-----------|------------|
| 1. Public Land Survey | T | <u>25N</u> | R | <u>2W</u> | <u>C-9</u> |
| | T | | R | | |
| | T | | R | | |
| | T | | R | | |
| 2. Property Controlling in Section | S | | T | R | |
| | S | | T | R | |
| 3. Miscellaneous Property in Sec. | S | | T | R | |
| | S | | T | R | |
| 4. Lot No. _____, Recorded Plat _____ | | | | | |
| 5. Private Claims _____ | | | | | |

STATE OF MICHIGAN

CITY OF CRAWFORD

FILED FOR RECORD THIS

30th DAY OF Dec, 1994 AT

4:20 am/pm, IN LIBER 3

PAGE 162

Register of Deeds Stamp & File Number
Register of Deeds

I, Marvin E. Myers, in a field survey on Dec 27, 1994, do hereby certify that under requirements of P.A. 74, Michigan P.A. of 1970, the corner points mentioned in lines 1 and 2 above were in conformance with regulations and rules therefore as required in the current manual of survey instructions of the United States Department of the Interior, Bureau of Land Management or by a decree of a Court of Law and/or that the corner points mentioned in lines 3, 4 and 5 above were in conformance with the rules of the Michigan Board of Land Surveyors or by a Decree of a Court of Law; established, re-established, monumented, re-monumented, recovered, found as expressed below:


A	B	C	D	E	F	G	H	I	J	K	L	M
2	6	5	4	3	2	1						
3												
4	7	8	9	10	11	12						
5												
6	18	17	16	15	14	13						
7												
8	19	20	21	22	23	24						
9												
10	30	29	28	27	26	25						
11												
12	31	32	33	34	35	36						
13												

NOTE: Not more than 4 corners, all in the same town and range, may be recorded on this certificate.

- A. Description of original monument and accessories and/or subsequent restoration:
- | | |
|---------------------------------|----------------------------------|
| GLO- D. Pettibone 1852 | F. J. Arleth L247, P555 7-86 |
| Mon-Set Post | Mon- $\frac{1}{2}$ " iron (1952) |
| Wit- 10" Spr. Pine North 45 lks | Wit- none given |
| 24" Y. Pine S77°E 1.93 chs. | |
- G. D. Henning L. 140, P 437 11-74
Mon- Found $\frac{1}{2}$ " Iron bar

B. Description of corner evidence found and/or method applied in restoring or reestablishing corner:
Found 14" Chaining pin alongside $\frac{1}{2}$ "x42" iron bar 4.5 E. of centerline of Stephan Bridge Road
Found $\frac{1}{2}$ " bar & cap #2240 on right of way N84°W 32.94
Accepted as the best available evidence of the position of the Original Corner.

- C. Description of monument for corner and accessories established to perpetuate locating the position of the corner:
Mon-Set standard Crawford County Monument marked cap "31600, T25N, R2W, C-9" in exact location of $\frac{1}{2}$ " bar.
Wit- Found $\frac{1}{2}$ " bar & cap #2240 N84°W 32.94
Set nail & tag NE side 14" B. Oak N42°W 42.91
Set nail & tag E. side 14" B. Oak S23°W 102.16
Set nail & tag N. side Utility Pole S84°E 30.96
Set carsonite post S86°E 33.00

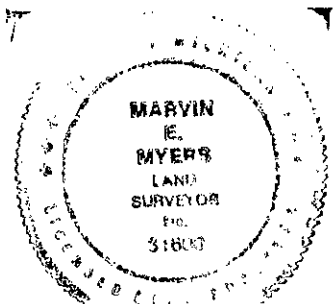

Signed by Marvin E. Myers

Date December 29, 1994

Surveyor's Michigan License No. 31600