

APR 27 1995

COMMISSION

CRAWFORD COUNTY
PEER GROUP APPROVAL
DATE Dec 29, 1994

LIBER 3 PAGE 175

LAND CORNER RECORDATION CERTIFICATE

Filing Requirement of Act 74, Mich. P.A. 1970 STATE OF MICHIGAN

For corners in

Crawford (County)	Located In:	Corner Code #
1. Public Land Survey	T 25N, R 2W	C-10
	T R	
	T R	
	T R	
2. Property Controlling in Section	S T R	
	S T R	
3. Miscellaneous Property in Sec.	S T R	
	S T R	

COUNTY OF CRAWFORD

FILED FOR RECORD THIS
30th DAY OF Dec, 1994 AT
4:20 am (pm) IN LIBER 3
PAGE 175

Register of Deeds Stamp & File Number

- 4. Lot No. _____, Recorded Plat _____
- 5. Private Claims _____

A	B	C	D	E	F	G	H	I	J	K	L	M
2	6	5	4	3	2							
3												
4	7	8	9	10	11	12						
5												
6	18	17	16	15	14	13						
7												
8	19	20	21	22	23	24						
9												
10	30	29	28	27	26	25						
11												
12	31	32	33	34	35	36						

I, Marvin E. Myers, in a field survey on Dec 28, 19 94, do hereby certify that under requirements of P.A. 74, Michigan P.A. of 1970, the corner points mentioned in lines 1 and 2 above were in conformance with regulations and rules therefore as required in the current manual of survey instructions of the United States Department of the Interior, Bureau of Land Management or by a decree of a Court of Law and/or that the corner points mentioned in lines 3, 4 and 5 above were in conformance with the rules of the Michigan Board of Land Surveyors or by a Decree of a Court of Law, established, re-established, monumented, re-monumented, recovered, found as expressed below:

NOTE: Not more than 4 corners, all in the same town and range, may be recorded on this certificate.

A. Description of original monument and accessories and/or subsequent restoration:


- | | | |
|---|--|---|
| GLO-D.Pettibone 1852
Mon-Set Post
Wit-24" Y. Pine S74°E 8.17
6" Spr. Pine N08°W 5.11
R. T. Ostling June 1947
Mon-found 1 1/2" Pipe
Wit-Old BT B. Oak 16" S16°W 22.7
Old BT B. Oak 8" N64°E 123.7
R.T. Ostling Sept 12, 1955
Mon- Pipe
Wit- none given | L120P277 C.E. Ostling Aug 24, 1972
Mon- Found 1/2" bar
Wit- 8" J. Pine N9°18'E 47.0
10" J. Pine S53°33'W 82.2
P.P. S73°24'E 103.65
LCRC L1, P208 C.E. Ostling 1972
Mon & wit: Same as above
L149, P173 G. Henning 10-30-1975
Mon- Not given Wit- none
L155, P471 N. Parker 8-12-1976
Mon- Not given: Wit- none | L157, P39 N. Parker Dec 3, 1976
Mon- 1/2" bar in blacktop
Wit- Spike in 12" J. Pine N15°E 42.0
P.Pole S41°E 46.6
L164, P369 N. Parker Aug 4 1977 Same as above
L166, P297 N. Parker Jan 18, 1978 Same as above
L247, P555 F. Arleth July 31, 1986
Mon- found 1/2" bar
Wit-T.Pole SE 103.7
6" J. Pine NE 46.9 |
|---|--|---|

B. Description of corner evidence found and/or method applied in restoring or reestablishing corner:

Found 3/4"x18" Iron rebar 3.3± South of Center line of Road; found spike SW side Utility Pole S42°E 46.80; found wit nail & tag NE face 13" J. Pine S60°W 82.20; found blaze SE face 9" J. Pine N50°W 94.6; found PK nail & tag S. face 13" J. Pine N14°E 47.15;
Accepted as the best available evidence of the position of the Original Corner.

C. Description of monument for corner and accessories established to perpetuate locating the position of the corner:

Set standard Crawford County Monument marked cap "31600, T25N, R2W, C-10 in monument box in exact location of found 1/2" iron rebar.
Wit-Set nail & tag SW side 9" J. Pine N50°W 94.91
Set carsonite post N03°E 36.70
Found PK nail & tag S. face 13" J. Pine N14°E 47.15
Found spike Sw side Utility Pole S42°E 46.80
Found blaze SE face 9" J. Pine N50°W 94.60
Found nail & tag NE face 13" J. Pine S60°W 82.20

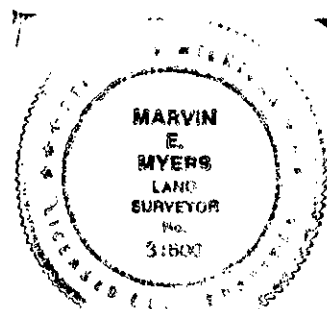

Signed by Marvin E. Myers

Date Dec 29, 1994

Surveyor's Michigan License No. 31600