

APR 27 1995

CRAWFORD COUNTY
PEER GROUP APPROVAL
DATE DEC 29, 1994
WEM

LIBER 3 PAGE 170 COMMISSION

LAND CORNER RECORDATION CERTIFICATE
Filing Requirement of Act 74, Mich. P.A. 1970

For corners in
Crawford
(County)

Located In:	Corner Code #
1. Public Land Survey T 25N, R 2W	D-9
T _____ R _____	_____
T _____ R _____	_____
T _____ R _____	_____
2. Property Controlling S _____ T _____ R _____	_____
in Section S _____ T _____ R _____	_____
3. Miscellaneous S _____ T _____ R _____	_____
Property in Sec. S _____ T _____ R _____	_____

STATE OF MICHIGAN
COUNTY OF CRAWFORD

FILED FOR RECORD THIS
30th DAY OF Dec, 1994 AT
4:20 am/pm IN LIBER 3
PAGE 170
Elizabeth W. Wilcox
Register of Deeds Stamp & File Number

4. Lot No. _____, Recorded Plat _____
5. Private Claims _____

	A	B	C	D	E	F	G	H	I	J	K	L	M
2	6	5	4	3	2								
3	7	8	9	10	11	12							
4	18	17	16	15	14	13							
5	19	20	21	22	23	24							
6	30	29	28	27	26	25							
7	31	32	33	34	35	36							

I, Marvin E. Myers, in a field survey on Dec 27, 1994, do hereby certify that under requirements of P.A. 74, Michigan P.A. of 1970, the corner points mentioned in lines 1 and 2 above were in conformance with regulations and rules therefore as required in the current manual of survey instructions of the United States Department of the Interior, Bureau of Land Management or by a decree of a Court of Law and/or that the corner points mentioned in lines 3, 4 and 5 above were in conformance with the rules of the Michigan Board of Land Surveyors or by a Decree of a Court of Law; established, re-established, monumented, re-monumented, recovered, found as expressed below:

NOTE: Not more than 4 corners, all in the same town and range, may be recorded on this certificate.

A. Description of original monument and accessories and/or subsequent restoration:

GLO-D. Pettibone 1852
Mon- Set Post
Wit- 18" Y. Pine S37°E 8.08
No other trees near


PLAT OF RIVER FOREST
Mon- 4" x 36" Conc. Mon.
Wit- NBT 10" W. Oak S78°E 39.8
NBT 8" B. Oak N13°E 39.8

B. Description of corner evidence found and/or method applied in restoring or reestablishing corner:

Found 4"x36" Concrete monument with 3/4"x56" iron rebar laying flat on ground nearby. Concrete monument is at old fence location (corner post and wire on ground). Found Blaze S. face of 13" B. Oak N18°E 39.6. Found Blaze in W. face 15" W. Oak S73°E 39.60
Replaced in exact location of concrete monument, set standard Crawford County Monument.
Accepted as the best available evidence of the position of the Original Corner.

C. Description of monument for corner and accessories established to perpetuate locating the position of the corner:

Mon-Set standard Crawford County Monument marked cap "31600, T25N, R2W, D-9".
Wit-Set nail & tag SW side 15" B. Oak S65°E 15.21
Set nail & tag NW side 13" B. Oak N54°E 10.04
Set nail & tag NE side 6" W. Oak N24°W 11.45
Set nail & tag NW side 15" TW. B. Oak S53°W 19.62
Set carsonite post N5°E 3.0

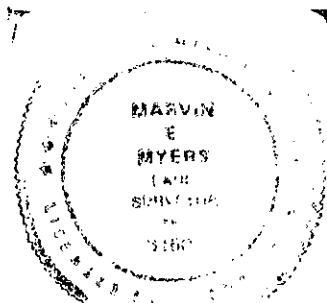

Signed by Marvin E. Myers
Surveyor's Michigan License No. 31600

Date December 29, 1994