

CRAWFORD COUNTY REMONUMENTATION  
**LAND CORNER RECORDATION CERTIFICATE**  
 Filing Requirement of Act 74, Mich. P.A. 1970

STATE OF MICHIGAN  
 COUNTY OF CRAWFORD

For corners in  
 CRAWFORD COUNTY  
 (County)

Located In:	Corner Code #
T 25N R 2W	D-11
T _____ R _____	_____
T _____ R _____	_____
T _____ R _____	_____
T _____ R _____	_____
2. Property Controlling in Section S _____ T _____ R _____	_____
S _____ T _____ R _____	_____
3. Miscellaneous Property in Sec. S _____ T _____ R _____	_____
S _____ T _____ R _____	_____

FILED FOR RECORD THIS  
 5th DAY OF Jan 1994 AT  
 11:15 am/pm, IN LIBER 3 4c  
 PAGE 119.  
*Elizabeth H. Wheland*  
 Register of Deeds  
 Register of Deeds Stamp & File Number

4. Lot No. \_\_\_\_\_, Recorded Plat \_\_\_\_\_  
 5. Private Claims \_\_\_\_\_

**LIBER 3 PAGE 119**

I, Marvin E. Myers, in a field survey on Dec, 1993, do hereby certify that under requirements of P.A. 74, Michigan P.A. of 1970, the corner points mentioned in lines 1 and 2 above were in conformance with regulations and rules therefore as required in the current manual of survey instructions of the United States Department of the Interior, Bureau of Land Management or by a decree of a Court of Law and/or that the corner points mentioned in lines 3, 4 and 5 above were in conformance with the rules of the Michigan Board of Land Surveyors or by a Decree of a Court of Law; established, re-established, monumented, re-monumented, recovered, found as expressed below:

A	B	C	D	E	F	G	H	I	J	K	L	M
2	6	5	4	3	2	1						
3												
4	7	8	9	10	11	12						
5												
6	18	17	16	15	14	13						
7												
8	19	20	21	22	23	24						
9												
10	30	29	28	27	26	25						
11												
12	31	32	33	34	35	36						
13												

**NOTE: Not more than 4 corners, all in the same town and range, may be recorded on this certificate.**

**A. Description of original monument and accessories and/or subsequent restoration:**

GLO- Aug 1852 D. Pettibone	L162 P549 Aug 1977 G. Henning
Mon- Post	Mon- Not Given
Wit- 22" Y Pine S2°W 23 lks	Wit- not given
20" Y. Pine S54°W 39 lks	
May 1944 G. Henning	L299 P 26 Nov 1987 F. Arleth
Mon- 3/4" Pipe in center line of Roads	Mon- 3/4" Pipe
Wit- 6" Norway Pine S34°E 110.7	Wit- 6" Norway S34°E 110.7
10" B. Oak S36°W 75.7	10" B. Oak S36°W 75.7
6" B. Oak N43°W 30.5	


Nov 1951 R. Ostling  
 Mon- Not given  
 Wit- Same as Hennings 1941

**B. Description of corner evidence found and/or method applied in restoring or reestablishing corner:**

Found 3/4" Pipe 14" below surface. Pipe broke off at 11" left rest of pipe in place verified position by measurement to accessories of record and accepted as best available evidence of the position of the Original Corner.

**C. Description of monument for corner and accessories established to perpetuate locating the position of the corner:**

Mon- Std 2" x 21" Crawford County Monument over 3/4" Pipe  
 Wit- Std. Nail & tag in SE side Utility Pole N62°E 49.34  
 Std. nail & tag in SW side 22" R. Pine (Norway) S27½E 110.39  
 Std. nail & tag in NW side 12" R. Pine (Norway) S44°W 46.09  
 STD. nail & tag in SW side 8" Poplar N30°W 64.75  
 Corner is in center line of Pioneer Road, 8'± West of center line of Road North, 17'± West of center line of Road South.

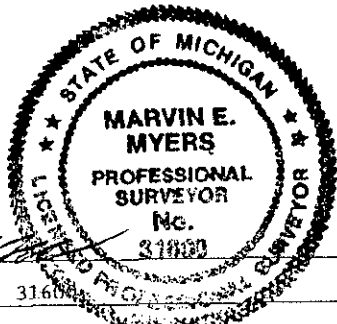

Signed by Marvin E. Myers  
 Surveyor's Michigan License No. 31604

Date Dec 27, 1993

DATE Dec 20, 1993

PEER GROUP APPROVED