

MAR 29 2000

SECTION

LAND CORNER RECORDATION CERTIFICATE
Filing Requirement of Act 74, Mich. P.A. 1970

For corners in

Crawford
(County)

Located In:

Corner Code #

1. Public Land Survey	T	R	
	T	25N	R 2W
	T	R	
	T	R	
2. Property Controlling in Section	S	T	R
	S	T	R
3. Miscellaneous Property in Sec.	S	T	R
	S	T	R

D-13

STATE OF MICHIGAN
CRAWFORD COUNTY
RECORDED

17 AUG 99 12:29 P.M.

SANDRA MOORE
REGISTER OF DEEDS

Register of Deeds Stamp & File Number

4. Lot No. _____, Recorded Plat _____
5. Private Claims _____

LIBER 4 PAGE 04

I, Marvin E. Myers, in a field survey on March, 1999 do hereby state that under requirements of P.A. 74, Michigan P.A. of 1970, the corner points mentioned in lines 1 and 2 above were in conformance with regulations and rules therefore as required in the current manual of survey instructions of the United States Department of the Interior, Bureau of Land Management or by a decree of a Court of Law and /or that the corner points mentioned in lines 3, 4 and 5 above were in conformance with the rules of the Michigan Board of Land Surveyors or by a Decree of a Court of Law, established, re-established, monumented, recovered, found as expressed below:

NOTE: Not more than 2 corners, all in the same town and range, may be recorded on this certificate.

A. Description of original monument and accessories and/or subsequent restoration:

G.L.O - 1838
John Brink D.S.
Mon. - Post
Wit: 8" P. Pine N29°W 23 links
14" Y. Pine N66°E 24 links

A.E. Newman, Surveyor, August 1901
Mon: Post
Wit: Old Bearing Yellow Pine Stump N66°E 25 links

Eugene Kiely, Surveyor
September 1902
Mon: Post
Wit: Old Bearing Yellow Pine Stump N66°E 25 links

Robert T. Ostling R.L.S.
December 1958, January 1959
Mon: 1/2" pipe
Wit: P. Pole S82 1/2°W 36.9' 10" Black Oak N40°E 72.1' T. Pole S69°E 36.1'

Larry L. Cavanagh, P.S.#17614
Liber 262, Page 642
Mon: 1/2" Bar
Wit: none provided

Larry L. Cavanagh, P.S.#17614
unrecorded survey dated December 5, 1989
Mon: 1/2" bar
Wit: 10" Jack Pine N35°W 28.1' P.P. N45°W 46.9'
12" B Oak N71°E 41.2' 1/2" Steel bar set N89°15'W 33.00'

B. Description of corner evidence found and/or method applied in restoring or reestablishing corner:


Found 1/2" steel bar of record in the centerline of Pine Road N. & S. raising a 1/2" pipe (Ostling) 2.3' below the surface.
Found nail & cap in 14" Jack Pine N78°E 58.03' Found 12" Black Oak N71°E 41.2
Found Power Pole N45°W 46.9' Found 1/2" Steel Bar N89°W 33.00'
Accepted 1/2" bar over 1/2" pipe as the best available evidence of the position of the Original Corner. Replace 1/2" bar with Standard Roscommon County monument.

C. Description of monument for corner and accessories established to perpetuate locating the position of the corner:

Mon: Standard Roscommon County corner over 1/2" pipe in monument box in centerline.
Wit: Found 1/2" Steel Bar N89°W 33.00' Found nail & cap in 14" Jack Pine N78°E 58.03'
Set nail & tag in guy pole S39°E 39.80' Set Carsonite Post East 33'
Found nail & tag in Power Pole N45°W 46.9'

CRAWFORD COUNTY
PEER GROUP APPROVAL
DATE June 7, 1999

Signed by Marvin E. Myers
Surveyor's Michigan License No. 31600

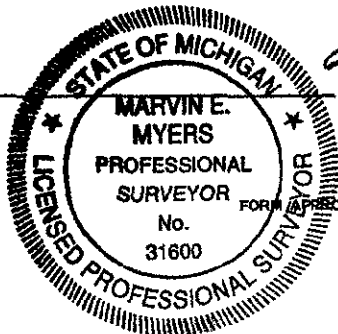

Date June 7, 1999
Marvin E. Myers
County Surveyor