


MAY 05 1997

COMMISSION

LAND CORNER RECORDATION CERTIFICATE

Filing Requirement of Act 74, Mich. P.A. 1970

For corners in <u>Crawford</u> (County)	Located In:	Corner Code #
1. Public Land Survey	T 25N R 2W	J - 13
	T R	
	T R	
	T R	
2. Property Controlling in Section	S T R	
	S T R	
3. Miscellaneous Property in Section	S T R	
	S T R	

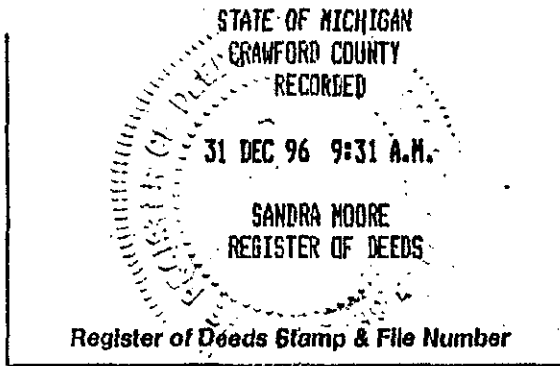

4. Lot No. _____, Recorded Plat _____
5. Private Claims _____

LIBER 3 PAGE 251

I, Marvin E. Myers, in a field survey on November, 1996, do hereby certify that under requirements of P.A. 74, Michigan P.A. of 1970, the corner points mentioned in lines 1 and 2 above were in conformance with regulations and rules therefore as required in the current manual of survey instructions of the United States Department of the Interior, Bureau of Land Management or by a decree of a Court of Law and/or that the corner points mentioned in lines 3, 4 and 5 above were in conformance with the rules of the Michigan Board of Professional Surveyors or by a Decree of a Court of Law; established, re-established, monumented, re-monumented, recovered, found as expressed below:

A	B	C	D	E	F	G	H	I	J	K	L
2	6	5							2		
3											
4	7	9	9	10	11	12					
5											
6	18	17	18	15	14	13					
7											
8	19	20	21	22	23	24					
9											
10	30	29	28	27	26	25					
11											
12	31	32	33	34	35	36					
13											

NOTE: Not more than 4 corners, all in the same town and range, may be recorded on this certificate.

A. Description of original monument and accessories and/or subsequent restoration:

GLO W. Burt June 1852 Mon.-Post WIT: 8" P.Pine N34°W 1.64 lks. 7" P.Pine N26½°E 115 lks.	L.257, pg.631 Same as L.1, pg. 25 C.E. Ostling Dec. 1972 L.270, pg.648 Mon.-Fd. mon. box WIT: 8" J.Pine S44°43'W 42.3' 8" J.Pine N56°43'W 82.9' 6" J.Pine N18°26'E 43.8'	F.J. Arleth L.320, pg.426 Mon.-Fd. ½" bar in pav't box WIT: 8" J.Pine S44°43'W 42.3' 8" J.Pine N56°43'W 82.9' 6" J.Pine N18°26'E 43.8'
E. Ostling 1972 L.270, pg.643 Mon.-Fd. mon. box WIT: 8" J.Pine S44°43'W 42.3' 8" J.Pine N50°43'W 82.9' 6" J.Pine N18°26'E 43.8'	L.3, pg.469 Mon.-Mon. Box WIT: 8" J.Pine S44°W 42.3' 8" J.Pine N56°W 82.9' 6" J.Pine N18°E 43.8'	F.J. Arleth L. 610, pg. 263 1980 Same as L. 320, pg. 426
C.E. Ostling Jan. 11, 1972 L.1, pg.25 Mon.- WIT: 8" J.Pine N25°E 43.9' NW Cor. of hse. S15°E 64.0' NE Cor. of hse. S35°E 76.0'		L.1, pg.56 PLAT OF LIVINGSTONE ACRES 5-23-58 G.D. Henning Mon.-Mon. box in pav't

B. Description of corner evidence found and/or method applied in restoring or reestablishing corner:

Found monument box with 1½" pipe inside
Found NW corner of house S09°E 57.3'
Found NE corner of house S30°E 76.2'
Found 10" J.Pine S50°W 42.2'
1.8' South of E-W centerline on line with fence line South

Accepted as the best available evidence of the position of the original corner.

C. Description of monument for corner and accessories established to perpetuate locating the position of the corner:

Replaced 1½" pipe with Standard Roscommon County monument in pav't box
WIT: Nail & tag 8" J.Pine N33°E 49.69'
Nail & tag 6" J.Pine N45°W 68.61'
Nail & tag 10" J.Pine S50°W 42.38'
Nail & tag 18" R.Pine S40°E 85.26'

CRAWFORD COUNTY
PEER GROUP APPROVAL
DATE NOV 22 1996

Marvin E. Myers
Marvin E. Myers, P.S.
County Surveyor



Signed by *Marvin E. Myers*

Date Dec. 13, 1996

Surveyor's Michigan License No. 31600