

**SURVEY &
REMONUMENTATION**

MAY 05 1997


LAND CORNER RECORDATION CERTIFICATE
Filing Requirement of Act 74, Mich. P.A. 1970

For corners in COMMISSION
Crawford (County)

Located In:

Corner Code #

1. Public Land Survey	T	<u>25N</u>	R	<u>2W</u>	<u>K - 13</u>	
	T	_____	R	_____	_____	
	T	_____	R	_____	_____	
	T	_____	R	_____	_____	
2. Property Controlling in Section	S	_____	T	_____	R	_____
	S	_____	T	_____	R	_____
3. Miscellaneous Property in Section	S	_____	T	_____	R	_____
	S	_____	T	_____	R	_____

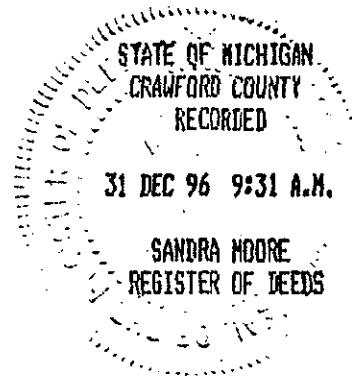

Register of Deeds Stamp & File Number

4. Lot No. _____, Recorded Plat _____
5. Private Claims _____

LIBER 3 PAGE 252

I, Marvin E. Myers, in a field survey on November 18, 1996, do hereby certify that under requirements of P.A. 74, Michigan P.A. of 1970, the corner points mentioned in lines 1 and 2 above were in conformance with regulations and rules therefore as required in the current manual of survey instructions of the United States Department of the Interior, Bureau of Land Management or by a decree of a Court of Law and/or that the corner points mentioned in lines 3, 4 and 5 above were in conformance with the rules of the Michigan Board of Professional Surveyors or by a Decree of a Court of Law; established, re-established, monumented, re-monumented, recovered, found as expressed below:

	A	B	C	D	E	F	G	H	I	J	K	L	M
2	6	5	4	3	2	1							
3													
4	7	6	5	4	3	2	1						
5													
6													
7													
8	18	17	16	15	14	13	12	11	10	9	8	7	6
9													
10	19	18	17	16	15	14	13	12	11	10	9	8	7
11													
12	30	29	28	27	26	25	24	23	22	21	20	19	18
13													
14	31	30	29	28	27	26	25	24	23	22	21	20	19
15													

NOTE: Not more than 4 corners, all in the same town and range, may be recorded on this certificate.

A. Description of original monument and accessories and/or subsequent restoration:

G.O. W. Burt June 19, 1852 Mon.-Post WIT: 4" S.Pine N20°W 11 lks. 4" S.Pine N59°E 66 lks. 4" S.Pine S20°E 46 lks. 4" S.Pine S62°W 50 lks.	G.D. Henning L.3 of Plats, pg.17 DEERHEART WOODS Mon.-1½" Pipe C.E. Ostling 1-11-1972 L.1, pg.25 Mon.- WIT: P.P. N30°E 57.0' P.P. base 47.2' 6" J.Pine S15°W 92.0'	L.L. Cavanagh 10-22-1973 L.282, pg.643 Mon.-Unknown WIT: None given F.J. Arleth Jan. 13, 1973 L. 213 pg.248 (Crawford County) Mon.-pav't box F.J. Arleth May 1989 L.549, pg.531 Mon.-pav't box WIT: SE cor. of E. GTE box NW 69.1' T.Pole NE 56.4'
G.D. Henning Oct. 30, 1946 Mon.-Cor. placed in center of road North & on line between cor. a mile E. & W. 1½" Pipe in corner	C.E. Ostling Jan. 11, 1972 L.257, pg.631 Mon.-Pd. mon. box WIT: P.P. N30°E 57.0' P.P. S45°E 47.2' 6" J.Pine S51°W 92.0'	L.2, pg.468 Mon.-mon. box WIT: P.P. N30°E 57.0' P.P. S45°E 47.2' 6" J.Pine S51°W 92.0'
L1, pg.56 PLAT OF LIVINGSTONE 46RES 5-23-1958 (Crawford Cty.) G.D. Henning Mon.-Mon. box in pav't		

B. Description of corner evidence found and/or method applied in restoring or reestablishing corner:

Found 1½" x 30" Pipe in monument box one foot below monument box verified
WIT: SE Corner of E. GTE Box NW 69.1'
2.5' South of centerline of East - West centerline,
and is accepted as the best available evidence of the position of the Original Corner

C. Description of monument for corner and accessories established to perpetuate locating the position of the corner:

Placed standard Roscommon County monument in pav't box
WIT: Nail & tag in P.P. N31°E 551.32'
Nail & tag in P.P. N30°W 552.59'
Nail & tag in 4" R.Pine S32°W 399.75'
Nail & tag in 12" R.Pine S26°E 387.22'

**CRAWFORD COUNTY
PEER GROUP APPROVAL
DATE NOV 22 20 1996**

Marvin E. Myers
**Marvin E. Myers, P.S.
County Surveyor**



Signed by _____ Date _____

Surveyor's Michigan License No. 31600