SURVEY & RE-MONUMENTATION

MAY 05 1997

COMMISSION

LAND CORNER RECORDATION CERTIFICATE

Filing Requirement of Act 74, Mich. P.A. 1970

For corners in Crawford (County) Located in: Corner Code # /

1. Public Land Survey		T 25N	R 2W	L - 13
		T ____	R ____	
		T ____	R ____	
		T ____	R ____	
2. Property Controlling	S ____	T ____	R ____	
in Section	S ____	T ____	R ____	
3. Miscellaneous	S ____	T ____	R ____	
Property in Section	S ____	T ____	R ____	

STATE OF MICHIGAN
CRAWFORD COUNTY
RECORDED
31 DEC 96 9:32 A.M.
SANDRA MOORE
REGISTER OF DEEDS

Register of Deeds Stamp & Deed Number

4. Lot No. _____, Recorded Plat _____
5. Private Claims _____

LIBER 3 PAGE 253

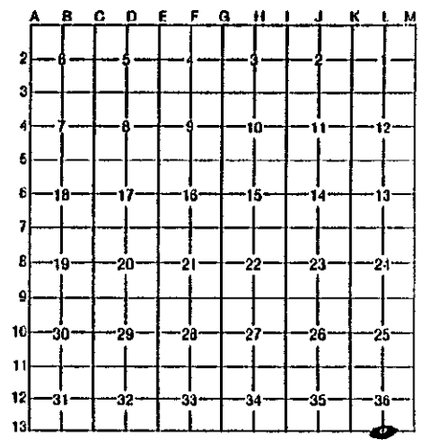

I, Marvin E. Myers, in a field survey on November, 1996, do hereby certify that under requirements of P.A. 74, Michigan P.A. of 1970, the corner points mentioned in lines 1 and 2 above were in conformance with regulations and rules therefore as required in the current manual of survey instructions of the United States Department of the Interior, Bureau of Land Management or by a decree of a Court of Law and/or that the corner points mentioned in lines 3, 4 and 5 above were in conformance with the rules of the Michigan Board of Professional Surveyors or by a Decree of a Court of Law; established, re-established, monumented, re-monumented, recovered, found as expressed below:

NOTE: Not more than 4 corners, all in the same town and range, may be recorded on this certificate.

A. Description of original monument and accessories and/or subsequent restoration:

GLO William Burt June 1852
Mon.-Post
WIT: 4" S.Pine N05°E 30 lks.
4" S.Pine N73°W 8 lks.

G.D. Henning Oct. 30 1946
Mon.-Set 3/4" Pipe on line at mid point
WIT: Mk'd B.T. 7" J.Pine N15°W 56.3'
Mk'd B.T. 5" J.Pine S46°W 99.2'

G.D. Henning 1947 L.3 of Plats, pg.17
DEERHEART WOODS
Mon.-Pipe in corner
WIT: BT 7" J.Pine N15°W 56.3'
BT 5" J.Pine S46°W 99.2'

G.D. Henning Aug. 31, 1978
L.174, pg.280 (Crawford County)
Mon.- Not given

F.J. Arleth Jan. 13, 1983
L.213, pg.248 (Crawford County)
Mon.-Fd. RR Spike

B. Description of corner evidence found and/or method applied in restoring or reestablishing corner:

Found monument box with 1" Iron Bar
Found J.Pine with B.T. Blaze N15°W 56.3'
½" bar & cap #2240 North 33.00'

Accepted as the best available evidence of the position of the Original Corner.

C. Description of monument for corner and accessories established to perpetuate locating the position of the corner:

Replaced 1" iron bar with standard Roscommon County Monument
WIT: Nail & tag in P.P. N40°E 37.65'
Nail & tag in P.P. N66°W 87.37'
Nail & tag in P.P. S43°E 42.84'
Nail & tag in 10" J.Pine S19°W 32.34'
Fd. ½" bar & cap #2240 North 33.0'

CRAWFORD COUNTY
PEER GROUP APPROVAL
DATE Nov 22, 1996
Marvin E. Myers PS
Marvin E. Myers, P.S.
County Surveyor

Signed by Marvin E. Myers Date December 13, 1996

Surveyor's Michigan License No. 31600

FORM APPROVED BY MICHIGAN STATE BOARD OF PROFESSIONAL SURVEYORS, JAN. 28, 1974
REVISED MAY 14, 1975
REVISED JAN., 1983