

STATE OF MICHIGAN  
DEPARTMENT  
OF  
NATURAL RESOURCES

LAND CORNER RECORD


CRAWFORD COUNTY  
T 25 N R 2 W

DESCRIPTION OF CORNER 1/16 at center of NE 1/4

CORNER MONUMENT Set 1"x24" pipe

DATE MONUMENT PLACED AND WITNESSED 9-2-71

WITNESSES TO CORNER.....

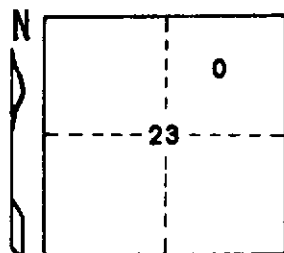

7" J. Pine N 55 W 30.6'


8" R. Pine N 43 E 75.3'

AND

CIRCLE CORNER REGISTERED

DESCRIPTION IN DETAIL AS TO HOW CORNER WAS LOCATED AND IDENTIFIED OR RESTORED.

Corner set by standard survey procedure for the subdivision of sections.

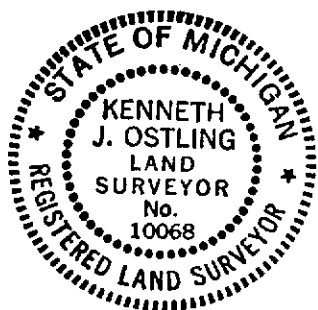

SURVEYOR'S SEAL

SIGNED

*Kenneth J. Ostling*  
REGISTERED LAND SURVEYOR  
10068

DATE

9-9-71

DISTRIBUTION:

County Courthouse  
Area Forester (Regions I & II)  
District or Region Surveyor  
Forestry Div., Lansing