

STATE OF MICHIGAN
DEPARTMENT
OF
NATURAL RESOURCES

LAND CORNER RECORD


CRAWFORD COUNTY
T 25 N R 2 W

DESCRIPTION OF CORNER S 1/16 on East Section line, Section 22

CORNER MONUMENT Set 1"x24" pipe

DATE MONUMENT PLACED AND WITNESSED 9-2-71

WITNESSES TO CORNER.....

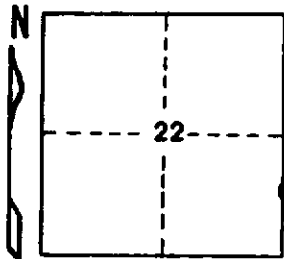

6" J. Pine N 72 W 13.6'


2" W. Pine N 30 E 4.5'

AND

CIRCLE CORNER REGISTERED

DESCRIPTION IN DETAIL AS TO HOW CORNER WAS LOCATED AND IDENTIFIED OR RESTORED.

Corner set by standard survey procedures for the subdivision of sections.

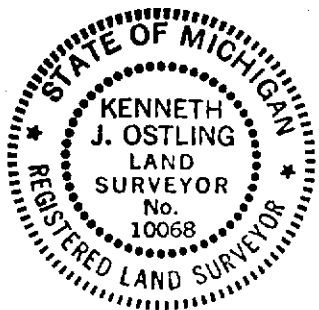

SURVEYOR'S SEAL

DISTRIBUTION:

SIGNED

Kenneth J. Ostling
REGISTERED LAND SURVEYOR 10068

DATE

9-9-71

County Courthouse
Area Forester (Regions I & II)
District or Region Surveyor
Forestry Div., Lansing