

LAND CORNER RECORDATION CERTIFICATE

Filing Requirement of Act 74, Mich. PA 1970

For Corners In:
Crawford
 (County)

	Located In		Corner Code #
1. Public Land Survey	T _____		_____
	T _____	R _____	_____
2. Property Controlling in Section	S 4 _____	T 25N R 3W _____	14 _____
	S _____		_____
3. Miscellaneous Property in Section	S _____	T _____	R _____
	S _____	T _____	R _____


4. Lot No: _____ Recorded Plat: _____

5. Private Claims: _____

I, Carl T. Kiiskila, in a field survey on May 3, 2005 do hereby state that under requirements of PA 74, Michigan PA of 1970, the corner points mentioned in lines 1 and 2 above were in conformance with regulations and rules therefore as required in the current manual of survey instructions of the United States Department of the Interior, Bureau of Land Management or by a decree of a Court of Law and/or that the corner points mentioned in lines 3, 4 and 5 above were in conformance with the rules of the Michigan Board of Land Surveyors or by a Decree of a Court of Law; established, re-established, monumented, recovered, found as expressed below:

NOTE: Not more than 2 corners, all in the same town and range, may be recorded on this certificate.

Register of Deeds Stamp & File Number

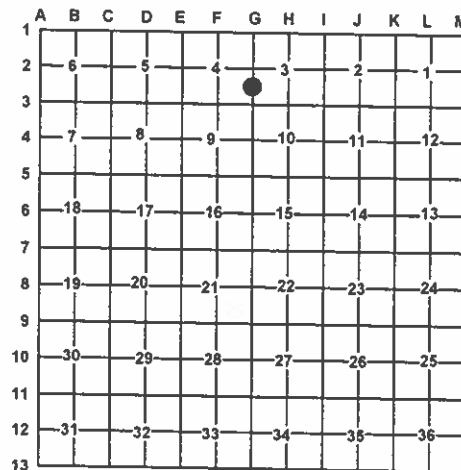

A. Description of original monument and accessories and/or subsequent restoration:

14- Norman F. Parker RLS #16939 set this corner while doing a survey in section 4.


B. Description of corner evidence found and/or method applies in restoring or re-establishing corner:

14- Found a 1/2" rod as set by Norman F. Parker RLS #16939 for the Northeast corner of the Southeast quarter of the Southeast quarter of section 4. This position fits B.L.M. instructions for the subdivision of a section.

C. Description of monument for corner and accessories established to perpetuate locating the position of the corner:

14- Added PS cap #33981 to the found 1/2" rod

Wit: 8" J. Pine	N84°E	16.85'
13" J. Pine	S05°E	26.62'
8" J. Pine	N41°E	30.79'
13 J. Pine	S61°W	31.35'
CTR N-S trail road	West	10'

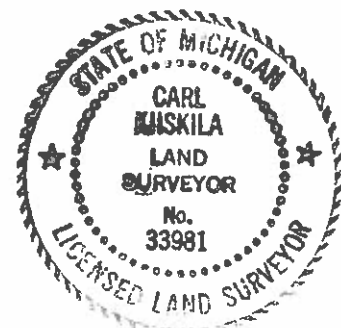

Signed by: Carl T. Kiiskila

Date: 6/30/05

Surveyor's Michigan License No.: 33981