

LAND CORNER RECORDATION CERTIFICATE
Filing Requirement of Act 74, Mich P.A. 1970

For corners in
Crawford County

LIBER 3 PAGE 267

STATE OF MICHIGAN
COUNTY OF CRAWFORD

FILED FOR RECORD THIS
20 DAY OF Nov, 1997 AT
9:30 am/pm, IN LIBER 3 of
PAGE 267.

Janice Moore
Register of Deeds

Register of Deeds Stamp & File Number

1. Public Land Survey

Located in: Corner Code #


T25N	R 4W	M-2
T25N	R 3W	A-2
T	R	
T	R	

I, Larry L. Cavanagh, in a field survey September, 1997, do hereby certify that under requirements of P.A. 74, Michigan P.A. of 1970, the corner points mentioned in line 1 above was in conformance with regulations and rules therefore as required in the current manual of survey instructions of the United States Department of the Interior, Bureau of Land Management or by a decree of a Court of Law; established, re-established, monumented, recovered, found as expressed below:

A. Description of original monument and accessories and/or subsequent restoration:

ADDISON P. BREWER
SET POST 1852
Y. PINE 24 N18°W 45 LKS
W. PINE 16 S13°W 67 LKS

NOMRAN F. PARKER 16939
LCRC LIBER 2, PAGE 51, 1973
½ BAR SET BY R. OSTLING 1960
NAIL IN 16" N. PINE S70°E 39.6'
NAIL IN 16" OAK N47°W 55.8'
NAIL IN 6" MAPLE S36°W 66.3'

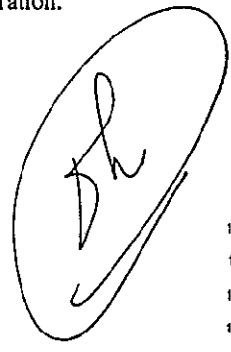

	A	B	C	D	E	F	G	H	I	J	K	L	M
2	6	5	4	3	2	1							
3													
4	7	8	9	10	11	12							
5													
6	18	17	16	15	14	13							
7													
8	19	20	21	22	23	24							
9													
10	30	29	28	27	26	25							
11													
12	31	32	33	34	35	36							
13													

B. Description of corner evidence found and/or method applied in restoring or reestablishing corner:

FOUND IRON BAR 1" X 3' (AXLE)
NAIL IN 16" N. PINE S70°E 39.6'

C. Description of monument for corner and accessories established to perpetuate locating the position of the corner:

SET CRAWFORD COUNTY MONUMENT STAMPED 17614 1997
NAIL & TAG IN 4" B. OAK N77°W 87.82'
NAIL & TAG IN 1" MAPLE S34°W 81.51'
NAIL & TAG IN 24" NORWAY PINE S70°E 40.24'
NAIL & TAG IN 7" CHERRY N77°E 53.24'
CARSONITE POST S82°E 24.95'

THE BEST AVAILABLE EVIDENCE OF THE POSITION OF THE ORIGINAL CORNER.

CRAWFORD COUNTY
PEER GROUP APPROVAL
DATE 20/16/1997

Marvin E. Myers
Marvin E. Myers, P.S.
County Surveyor



APR 03 1998

Signed by *Larry L. Cavanagh*
Surveyor's Michigan License NO. 17614

Date Oct 22, 1997