

MAY 05 1997

COMMISSION

LAND CORNER RECORDATION CERTIFICATE

Filing Requirement of Act 74, Mich. P.A. 1970

For corners in Crawford (County)

Located In:

Corner Code #

1. Public Land Survey

T 25N R 3W A-8
T 25N R 4W M-8

2. Property Controlling in Section

S T R
S T R

3. Miscellaneous


S T R

Property in Section

S T R

4. Lot No. _____, Recorded Plat _____

5. Private Claims _____

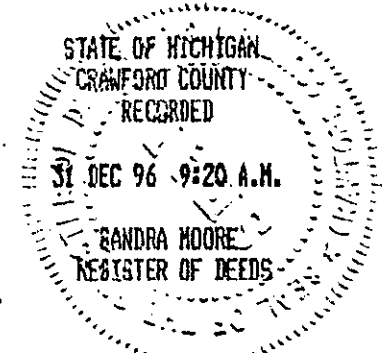

Register of Deeds Stamp & File Number

LIBER 3 PAGE 243

I, Larry L. Cavanagh, in a field survey on November, 1996, do hereby certify that under requirements of P.A. 74, Michigan P.A. of 1970, the corner points mentioned in lines 1 and 2 above were in conformance with regulations and rules therefore as required in the current manual of survey instructions of the United States Department of the Interior, Bureau of Land Management or by a decree of a Court of Law and/or that the corner points mentioned in lines 3, 4 and 5 above were in conformance with the rules of the Michigan Board of Professional Surveyors or by a Decree of a Court of Law; established, re-established, monumented, re-monumented, recovered, found as expressed below:

Grid table with columns A-L and rows 2-13. Numbers are placed in various cells: 6, 6, 3, 2, 7, 8, 9, 10, 11, 12, 18, 17, 18, 15, 14, 13, 19, 20, 21, 22, 23, 24, 30, 29, 28, 27, 26, 25, 31, 32, 33, 34, 35, 36.

NOTE: Not more than 4 corners, all in the same town and range, may be recorded on this certificate.

A. Description of original monument and accessories and/or subsequent restoration:

ADDISON BREWER 1852
SET POST
WIT: S. PINE 8" N50°15'W 553 LKS
S. PINE 10" S28°15'W 616 LK S

CARL F. ROSER 1995
LCRCL3, PG 2
FD CAPPED IRON - B JONES #23514
WIT: FD REROD S89°5'W 32.96'
P. POLE S88°E 27.36'
6" J. PINE S54°W 42.07'
18" J. PINE N40°E 61.34'
4" J. PINE N42°W 72.88'

GEORGE D. HENNING 1954
SET 1/2" X 24" IRON
11" J. PINE S83°W 58.50'
14" J. PINE N36°E 61.0'
10" J. PINE N31°W 104.0'

B. Description of corner evidence found and/or method applied in restoring or reestablishing corner:

FOUND 1/2" CAPPED BAR B. JONES BAR OVER 1/2" BAR
FOUND NAIL IN POWER POLE N88°E 27.36'
FOUND D.N.R. TAG IN 4" J. PINE N42°W 72.88'
FOUND NAIL IN 6" J. PINE S54°W 42.07'
FOUND NAIL IN 18" J. PINE N40°E 61.34'
FOUND REROD S89°05'W 32.96'
SEE MAP IN DOSSIER

CRAWFORD COUNTY

PEER GROUP APPROVAL

DATE NOV 22, 1996

Marvin E. Myers

Marvin E. Myers, P.S.
County Surveyor

C. Description of monument for corner and accessories established to perpetuate locating the position of the corner:

SET STANDARD CRAWFORD COUNTY MONUMENT BRASS, STAMPED 1996 #17614
WIT: POWER POLE N88°E 27.36'
4" J. PINE N48°W 73.88'
10" J. PINE S48°W 42.07'
18" J. PINE N34°E 61.34'
CARSONITE POST NE 29.45'
THE BEST AVAILABLE EVIDENCE OF THE POSITION OF THE ORIGINAL CORNER.



Signed by Larry L. Cavanagh
Surveyor's Michigan License No. 17614

Date Nov. 29, 1996