

MAY 05 1997

COMMISSION LAND CORNER RECORDATION CERTIFICATE

Filing Requirement of Act 74, Mich. P.A. 1970

For corners in Crawford (County)

Located In:

Corner Code #

1. Public Land Survey

T 25N R 3W


A-10

2. Property Controlling in Section

S T R

3. Miscellaneous Property in Section

S T R

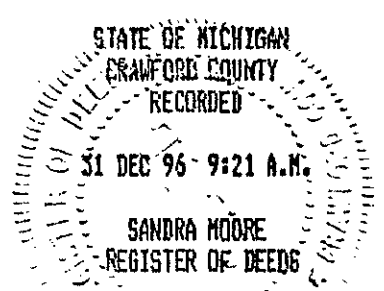

4. Lot No. , Recorded Plat

5. Private Claims

LIBER 3 PAGE 247

I, Larry L. Cavanagh, in a field survey on November, 1996 do hereby certify that under requirements of P.A. 74, Michigan P.A. of 1970, the corner points mentioned in lines 1 and 2 above were in conformance with regulations and rules therefore as required in the current manual of survey instructions of the United States Department of the Interior, Bureau of Land Management or by a decree of a Court of Law and/or that the corner points mentioned in lines 3, 4 and 5 above were in conformance with the rules of the Michigan Board of Professional Surveyors or by a Decree of a Court of Law; established, re-established, monumented, re-monumented, recovered, found as expressed below:

Grid table with columns A-M and rows 2-13

NOTE: Not more than 4 corners, all in the same town and range, may be recorded on this certificate.

A. Description of original monument and accessories and/or subsequent restoration:

POST SET BY ADDISON P. BREWER 1852 WIT: S PINE 10" N10°W 33 LKS S PINE 10" S80°W 45 LKS

CARL F. ROSER 1995 LCRC L3, P216 FOUND 1/2" REROD BENT. REPLACED WITH 5/8" X 32" REROD WIT: SET CED POST EAST 1.5' 8" J. PINE N71°E 92.54'

FRANK J. ARLETH, LLS 1989 FD 1/2" BAR 29.3' WEST OF LINE CENTER OAK RD WIT: SP IN P. POLE EAST 58.3' SP IN 12" W. PINE S50°E 104.5' SP IN 18" W. PINE S25°W 66.9'

P. POLE S85°E 58.06' 4" J. PINE N18°W 44.17' 10" J. PINE S20°W 43.01' FD IRON IN CONC N82°E 5.55'

B. Description of corner evidence found and/or method applied in restoring or reestablishing corner:

FD 5/8 BAR IN WEST DITCH FD CEDAR POST EAST 1.5' FD 8" J. PINE N71°E 92.54' FD P. POLE S85°E 58.06' FD 4" J. PINE N18°W 44.17' FD 10" J. PINE S20°W 43.01' FD IRON IN CONC. N82°E 5.55' SEE MAP IN DOSSIER

CRAWFORD COUNTY PEER GROUP APPROVAL DATE NOV 22 1996

Marvin E. Myers, P.S. County Surveyor

C. Description of monument for corner and accessories established to perpetuate locating the position of the corner:

SET STANDARD CRAWFORD COUNTY MONUMENT BRASS, STAMPED 1996 #17614 WIT: 10" J. PINE N65°E 92.49' P. POLE N89°E 58.05' 10" J. PINE S16°W 43.01' 5" J. PINE N25°W 44.14' CARSONITE POST NW 1.4' THE BEST AVAILABLE EVIDENCE OF THE POSITION OF THE ORIGINAL CORNER.



Signed by Larry L. Cavanagh 17614

Date Nov 22 1996