

SURVEY & REMONUMENTATION

MAY 05 1987


LAND CORNER RECORDATION CERTIFICATE
Filing Requirement of Act 74, Mich. P.A. 1970

For corners in COMMISSION
Crawford
 (County)

Located In:

Corner Code #

1. Public Land Survey	T	<u>25N</u>	R	<u>3W</u>	<u>A-13</u> ✓
	T	<u>25N</u>	R	<u>4W</u>	<u>M-13</u> ✓
	T	_____	R	_____	_____
	T	_____	R	_____	_____
2. Property Controlling in Section	S	_____	T	_____	_____
	S	_____	T	_____	_____
3. Miscellaneous Property in Section	S	_____	T	_____	_____
	S	_____	T	_____	_____

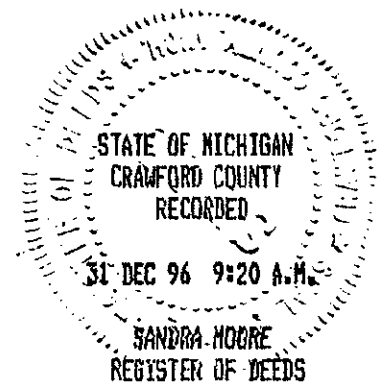

Register of Deeds Stamp & File Number

4. Lot No. _____, Recorded Plat _____
 5. Private Claims _____

LIBER 3 PAGE 241

I, Larry L. Cavanagh, in a field survey on November, 19 96, do hereby certify that under requirements of P.A. 74, Michigan P.A. of 1970, the corner points mentioned in lines 1 and 2 above were in conformance with regulations and rules therefore as required in the current manual of survey instructions of the United States Department of the Interior, Bureau of Land Management or by a decree of a Court of Law and/or that the corner points mentioned in lines 3, 4 and 5 above were in conformance with the rules of the Michigan Board of Professional Surveyors or by a Decree of a Court of Law; established, re-established, monumented, re-monumented, recovered, found as expressed below:

	A	B	C	D	E	F	G	H	I	J	K	L	M
2	6	5	4	3	2	1	1	1	1	1	1	1	1
3													
4	7	8	9	10	11	12							
5													
6	18	17	16	15	14	13							
7													
8	19	20	21	22	23	24							
9													
10	30	29	28	27	26	25							
11													
12	31	32	33	34	35	36							
13													

NOTE: Not more than 4 corners, all in the same town and range, may be recorded on this certificate.

A. Description of original monument and accessories and/or subsequent restoration:

POST SET BY JOHN BRINK 1839 WIT: WHITE OAK 10° N27°E 39 LKS WHITE OAK 9° S53 1/2°W 50 LKS	ROBERT T. OSTLING SEC. 6, SURVEY 1954 STEEL FENCE COR FOR SEC. COR NO WITNESSES	CARL JOHNSON 1987 CERT. OF SURVEY NO CORNER MATERIAL NOTED DISTANCE NOTED CLOSE TO MEASURED
G.F. DELAMATER 1938 FD PIPE IN CONCRETE IN COR WIT: S. PINE 5° N53°W 65.7' B. OAK 6° S28°E 41.5'	OSTLING SEC. SURVEY SEC. 5 & 6 1963 COTTAGE GROVE ASSOC. NO COR. MATERIAL NOTED	FRANK J. ARLETH 1987 L516 P26 NO CORNER MATERIAL NOTED NO WITNESSES
G.F. DELAMATER 1939 SECTION SURVEY 5 & 6 SHOWING COTTAGE GROVE ASS'N NO WITNESSES	NORMAN F. PARKER 1979 CERT. OF SURVEY L176, P526 STEEL FENCE POST IN COR. NO WITNESSES	FRANK J. ARLETH 1990 L343 P135 NO CORNER MATERIAL NOTED NO WITNESSES
HENNING & OSTLING SECTION SURVEY SECTION 6, 1947 STEEL FENCE COR FOR SECTION COR NO WITNESSES	NORMAN F. PARKER 1982 CERT OF SURVEY L209, P248 4" STEEL FENCE POST FOR SEC. COR. NO WITNESSES	FRANK J. ARLETH 1990 L349 P93 FENCE COR. IS SEC. COR. NO WITNESSES
		FRANK J. ARLETH 1992 L632 P326 NO CORNER MATERIAL NOTED NO WITNESSES

B. Description of corner evidence found and/or method applied in restoring or reestablishing corner:

FOUND STEEL FENCE POST CALLED FOR IN NORMAN PARKER'S SURVEY, SOUTH R/W OF COUNTY ROAD AND THE EAST SIDE OF OAK RD. ALSO FOUND WITNESS TREES WITH NAILS AND FLAGGING WHICH APPEAR TO FACE FENCE POST. LOOKED LIKE MYER'S WITNESSES. ALSO FOUND 1/2" BAR AOUNT 75 FEET NORTH OF CENTERLINE AND IN EAST EDGE OF GRAVEL WITH D.N.R. WITNESS POST 20 FEET EAST. THE PLATE ON THE WITNESS POST SEEMS TO INDICATE THAT THE MARKER IS ON THE SECTION LINE, NOT THE CORNER.
 WIT: 14" B. OAK S71°E 16.81'
 16" W. PINE S80°W 45.07'
 10" B. OAK N45°W 83.7'
 SEE MAP IN DOSSIER


C. Description of monument for corner and accessories established to perpetuate locating the position of the corner:

FENCE POST STAMPED MONUMENT POST 1996 #17614
 WIT: 14" B. OAK S71°E 16.81'
 16" W. PINE S80°W 45.07'
 10" B. OAK N45°W 83.7'
 *8" NORWAY N40°E 106.04'
 CARSONITE POST SE 3.2'

* NEW WITNESS

THE BEST AVAILABLE EVIDENCE OF THE POSITION OF THE ORIGINAL CORNER.

Signed by Larry L. Cavanagh
 Surveyor's Michigan License No. 17614

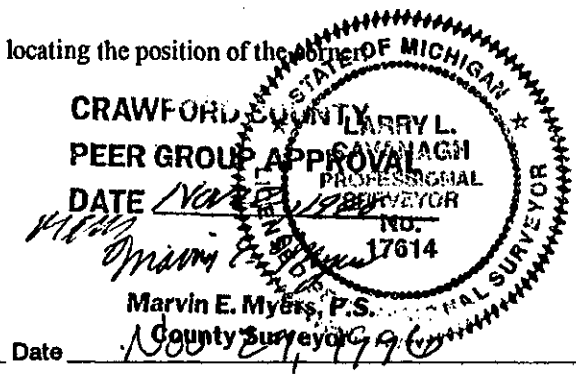

Date Nov 21, 1996
 Marvin E. Myers, P.S.
 County Surveyor