

LAND CORNER RECORDATION CERTIFICATE
 Filing Requirement of Act 74, Mich P.A. 1970

For corners in
 Crawford County

LIBER 3 PAGE 269

Located in: Corner Code #

1. Public Land Survey

T26N	R3W	B-13	✓
T25N	R3W	B-1	✓
T	R		
T	R		

STATE OF MICHIGAN
 COUNTY OF CRAWFORD

FILED FOR RECORD THIS
30 DAY OF Nov, 1997 AT
9:30 am/pm, IN LIBER 3 of
 PAGE 269.

Sandra Moore
 Register of Deeds

Register of Deeds Stamp & File Number

I, Larry L. Cavanagh, in a field survey September, 1997, do hereby certify that under requirements of P.A. 74, Michigan P.A. of 1970, the corner points mentioned in line 1 above was in conformance with regulations and rules therefore as required in the current manual of survey instructions of the United States Department of the Interior, Bureau of Land Management or by a decree of a Court of Law; established, re-established, monumented, recovered, found as expressed below:

A. Description of original monument and accessories and/or subsequent restoration:

ADDISON P. BREWER 1852 SET POST PINE 12 N84W 8 PINE 10 N27E 20	FRANK J. ARLETH 21266 1993 FD 1/2" BAR WIT 8" W. PINE S45°E 57.55' 8" B. OAK N64°E 70.95' 1/4 BAR 33 SOUTH
NORMAN PARKER 1973 LCRC LIBER 2, PAGE 51 FD 1/2" BAR IN BLACKTOP 1" PIPE NORTH 33' 4"X4" SCRIBED POST NORTH 33'	
K. J. OSTLING, 1975 FD 1/2" BAR BY PARKER SURVEY 1973	

	A	B	C	D	E	F	G	H	I	J	K	L	N
2	6	5	4	3	2	1							
3													
4	7	8	9	10	11	12							
5													
6	18	17	16	15	14	13							
7													
8	19	20	21	22	23	24							
9													
10	30	29	28	27	26	25							
11													
12	31	32	33	34	35	36							
13													

B. Description of corner evidence found and/or method applied in restoring or reestablishing corner:

FOUND 1/2" X 12" BAR 3.5 FEET NORTH OF CENTERLINE
 8" W PINE S45°E 57.55'
 8" B. OAK N64°E 70.95'
 1/2" BAR 33' SOUTH

C. Description of monument for corner and accessories established to perpetuate locating the position of the corner:


SET CRAWFORD COUNTY MONUMENT STAMPED 17614 1997
 * WIT: NAIL & TAG IN 11" J. PINE N30°W 52.19'
 * NAIL & TAG IN P. POLE S20°W 30.12'
 NAIL & TAG IN 12" NORWAY PINE S45°E 57.69'
 NAIL & TAG IN 9" OAK N64°E 70.88'
 CARSONITE POST NORTH 31.7'

*NEW WITNESSES

THE BEST AVAILABLE EVIDENCE OF THE POSITION OF THE ORIGINAL CORNER.

CRAWFORD COUNTY
PEER GROUP APPROVAL
 DATE Oct 16, 1997

Marvin E. Myers
 Marvin E. Myers, P.S.
 County Surveyor

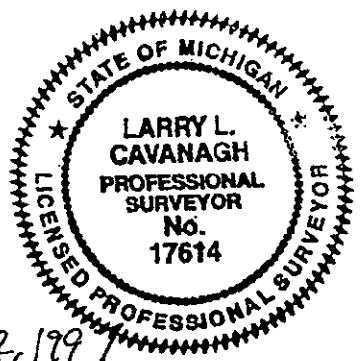

Signed by *Larry L. Cavanagh*
 Surveyor's Michigan License No. 17614

Date Oct 22, 1997