

COMMISSION LAND CORNER RECORDATION CERTIFICATE  
Filing Requirement of Act 74, Mich. P.A. 1970

For corners in Crawford Located in: \_\_\_\_\_ Corner Code # \_\_\_\_\_  
(County)

1. Public Land Survey T 25N R 3W 8-9  
T \_\_\_\_\_ R \_\_\_\_\_  
T \_\_\_\_\_ R \_\_\_\_\_  
T \_\_\_\_\_ R \_\_\_\_\_

2. Property Controlling S \_\_\_\_\_ T \_\_\_\_\_ R \_\_\_\_\_  
in Section S \_\_\_\_\_ T \_\_\_\_\_ R \_\_\_\_\_

3. Miscellaneous S \_\_\_\_\_ T \_\_\_\_\_ R \_\_\_\_\_  
Property in Section S \_\_\_\_\_ T \_\_\_\_\_ R \_\_\_\_\_

STATE OF MICHIGAN  
CRAWFORD COUNTY  
RECORDED  
27 DEC 95 3:41 P.M.  
SANDRA MOORE  
REGISTER OF DEEDS

Register of Deeds Stamp & File Number

4. Lot No. \_\_\_\_\_, Recorded Plat \_\_\_\_\_  
5. Private Claims \_\_\_\_\_

	A	B	C	D	E	F	G	H	I	J	K	L
2	6		5		4		3		2		1	
3												
4	7		8		9		10		11		12	
5												
6	18		17		16		15		14		13	
7												
8	19		20		21		22		23		24	
9												
10	30		29		28		27		26		25	
11												
12	31		32		33		34		35		36	
13												

I, Larry L. Cavanagh, in a field survey on November, 1995, do hereby certify that under requirements of P.A. 74, Michigan P.A. of 1970, the corner points mentioned in lines 1 and 2 above were in conformance with regulations and rules therefore as required in the current manual of survey instructions of the United States Department of the Interior, Bureau of Land Management or by a decree of a Court of Law and/or that the corner points mentioned in lines 3, 4 and 5 above were in conformance with the rules of the Michigan Board of Professional Surveyors or by a Decree of a Court of Law; established, re-established, monumented, re-monumented, recovered, found as expressed below:

NOTE: Not more than 4 corners, all in the same town and range, may be recorded on this certificate.

A. Description of original monument and accessories and/or subsequent restoration:

Post set by Addison P. Brewer in 1852 dead S. Pine 12" N51°W 48 Links Y. Pine 22" S54 1/2W 219 Links	G. D. Henning 1954 R. R. spike in road 7" J. Pine N27°E 35.0' 6" J. Pine N32°W 68.4' 8" J. Pine S50°W 103.1'	F. Arleth 1989 Fd iron in blacktop 7" J. Pine N27°E 35.0' 6" J. Pine N52°W 68.4' 8" J. Pine S50°W 103.1'
E. Newman 1908 set 1/4 post 1 old bearing standing Y. Pine 24" S54 1/2W 219 Links	L. Cavanagh 1973 Recorded survey Liber 135, Page 561 Found R.R. spike	


B. Description of corner evidence found and/or method applied in restoring or reestablishing corner:

Found R.R. spike under black top  
Found 6" J. Pine/blaze N32W 68.4 (bent over by storm)  
Found 8" J. Pine/blaze S50W 103.1 (top blown out)

CRAWFORD COUNTY  
PEER GROUP APPROVAL  
DATE Dec 19, 1995  
*Marvin E. Myers*  
Marvin E. Myers, P.S.  
County Surveyor

C. Description of monument for corner and accessories established to perpetuate locating the position of the corner:

Set 2 1/2" x 21' cast iron Crawford County Monument (in pavement box)  
Stamped I7614-1995  
Nail & Tag in 7" Twin Oak N15°E 33.55'  
Nail & Tag in 8" J. Pine (existing blaze) N57°W 61.99'  
Nail & Tag in 3" Oak S63°W 82.73'  
Nail & Tag in fence post S33°E 43.38'  
Carsonite post South 32.87'

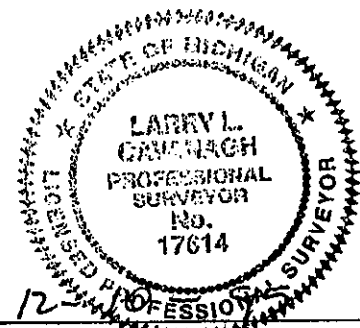

Signed by Larry L. Cavanagh  
Surveyor's Michigan License No. 17614

Date 12  
FORM APPROVED BY MICHIGAN STATE BOARD OF PROFESSIONAL SURVEYORS, JAN. 28, 1971  
REVISED MAY 14, 1975  
REVISED JAN., 1983