

MAY 05 1997

COMMISSION


LAND CORNER RECORDATION CERTIFICATE
Filing Requirement of Act 74, Mich. P.A. 1970

For corners in Crawford
(County)

Located In:

Corner Code #

- 1. Public Land Survey T 25N R 3W B-13
- T _____ R _____
- T _____ R _____
- T _____ R _____
- 2. Property Controlling S _____ T _____ R _____
- In Section S _____ T _____ R _____
- 3. Miscellaneous S _____ T _____ R _____
- Property in Section S _____ T _____ R _____

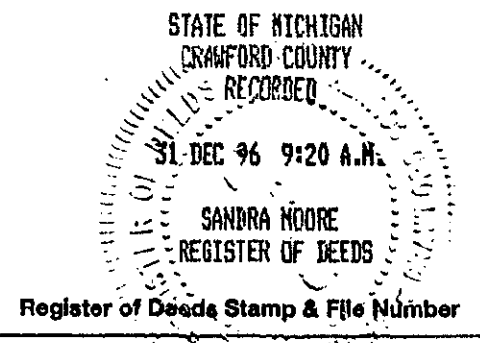

- 4. Lot No. _____, Recorded Plat _____
- 5. Private Claims _____

LIBER 3 PAGE 242

I, Larry L. Cavanagh, in a field survey on November, 1996, do hereby certify that under requirements of P.A. 74, Michigan P.A. of 1970, the corner points mentioned in lines 1 and 2 above were in conformance with regulations and rules therefore as required in the current manual of survey instructions of the United States Department of the Interior, Bureau of Land Management or by a decree of a Court of Law and/or that the corner points mentioned in lines 3, 4 and 5 above were in conformance with the rules of the Michigan Board of Professional Surveyors or by a Decree of a Court of Law; established, re-established, monumented, re-monumented, recovered, found as expressed below:

| | | | | | | | | | | | | | |
|----|----|---|----|---|----|---|----|---|----|---|----|---|---|
| | A | B | C | D | E | F | G | H | I | J | K | L | M |
| 2 | 6 | | 5 | | 4 | | 3 | | 2 | | | | |
| 3 | | | | | | | | | | | | | |
| 4 | 7 | | 8 | | 9 | | 10 | | 11 | | 12 | | |
| 5 | | | | | | | | | | | | | |
| 6 | 18 | | 17 | | 16 | | 15 | | 14 | | 13 | | |
| 7 | | | | | | | | | | | | | |
| 8 | 19 | | 20 | | 21 | | 22 | | 23 | | 24 | | |
| 9 | | | | | | | | | | | | | |
| 10 | 30 | | 29 | | 28 | | 27 | | 26 | | 25 | | |
| 11 | | | | | | | | | | | | | |
| 12 | 31 | | 32 | | 33 | | 34 | | 35 | | 36 | | |
| 13 | | | | | | | | | | | | | |

NOTE: Not more than 4 corners, all in the same town and range, may be recorded on this certificate.

A. Description of original monument and accessories and/or subsequent restoration:

POST SET BY JOHN BRINK 1839
WIT: WHITE OAK 10' N46 1/2°W 26 LKS
WHITE OAK 8' N 37 1/2°E 26 LKS

FRANK J. ARLETH 1990
CERT. OF SURVEY L343, P133
NO CORNER MATERIALS NOTED
NO WITNESSES

CARL R. JOHNSON 1987
CERT. OF SURVEY
NO CORNER MATERIAL NOTED
DISTANCE NOTED
CLOSE TO MEASURED DISTANCE

FRANK J. ARLETH
CERT. OF SURVEY 1990 L349, P93
Sp. in 6" B. Oak S28°W 33.9
Sp. in 6" B. Oak S42°30'E 22.00

B. Description of corner evidence found and/or method applied in restoring or reestablishing corner:


FD 1/2" BAR 5.5 FEET SOUTH OF SOUTH EDGE OF BLACK TOP. ALSO FOUND AND TIED IN WITNESS NAILS IN TREES
FD NAIL IN 3" B. OAK S46°E 29.31'
FD NAIL IN 6" B. OAK S39°W 37.0'
FD NAIL IN 8" W. OAK N37°W 64.65'
FD NAIL IN FENCE POST N17°E 55.15'
SEE MAP IN DOSSIER

CRAWFORD COUNTY
PEER GROUP APPROVAL
DATE NOV 22, 1996

Marvin E. Myers
Marvin E. Myers, P. S.
County Surveyor

C. Description of monument for corner and accessories established to perpetuate locating the position of the corner:

SET STANDARD ROSCOMMON COUNTY MONUMENT BRASS, STAMPED 1996 #17614
WIT: 3" B OAK S46°E 29.31'
6" B. OAK S39°W 37.0'
8" W. OAK N37°W 64.65'
FENCE POST N17°E 55.15'
CARSONITE POST SOUTH 18.05'
THE BEST AVAILABLE EVIDENCE OF THE POSITION OF THE ORIGINAL CORNER.

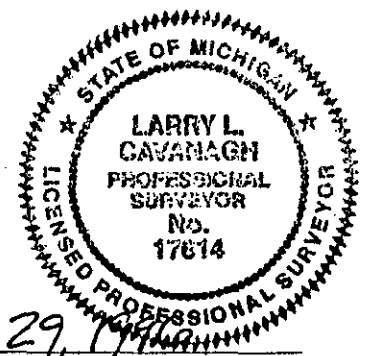

Signed by *Larry L. Cavanagh*
Surveyor's Michigan License No. 17614

Date Nov. 29, 1996